

MISSISSIPPI DEPARTMENT OF NATURAL RESOURCES

Bureau of Land and Water Resources

Southport Mall

P.O. Box 10631

Jackson, Mississippi 39209

WATER WELL DRILLERS LOG

CODED

SUNFLOWER

T 67

4-18  
date well completed

1984

Larry's well & pump  
firm name

Sunflower  
county well located

LANDOWNER: R. V. Duke

description of formations encountered

from to

Isola, ms.  
(mailing address)

clay	0	30
Fine Sand	30	50
coarse Sand	50	150

WELL LOCATION:

sec. 34 T 17 N R 4 W S  
1 miles N of Isola  
(distance) (direction) (nearest town)

WELL PURPOSE: Fish Pond  
(home, irrigation, municipal, industrial)

CODED

WELL COMPLETION DATA:

- (1) diameter (inches) 6"
- (2) total depth (feet) 100'
- (3) static water level (feet) 24' below top of ground.
- (4) casing PVC, 60' (material) (depth)
- (size) if telescope see back.
- (5) screen 40' length, 60' depth to top, 6" size, PVC material
- (6) pump 5 HP, 300 yield gpm, E type power
- (7) electric log NO (yes or no)

DEPT. OF NATURAL RESOURCES  
BUREAU OF LAND & WATER RESOURCES

OCT 12 1984

RECEIVED


(organization running log)

(8) how well bottom plugged PVC cap

DRILLERS REMARKS:

If well telescopes please sketch and show depths.

GROUND LEVEL

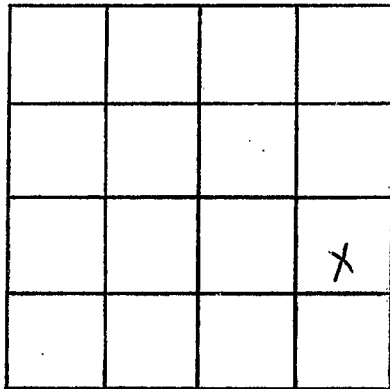

SECTION 34

Please indicate well location X.

ADDITIONAL INFORMATION

If more than one screen, show locations of each on sketch.