

MISSISSIPPI DEPARTMENT OF NATURAL RESOURCES

Bureau of Land and Water Resources

Southport Mall

P.O. Box 10631

Jackson, Mississippi 39209

WATER WELL DRILLERS LOG

CODED

SUNFLOWER  
T 68

4-16 1984 Larry's well's pump Sunflower  
date well completed firm name county well located

LANDOWNER: <u>Lee Arrington</u>	description of formations encountered	from	to
<u>Shiveness MO</u> (mailing address)	<u>slay</u>	0	30
	<u>Fine Sand</u>	30	60
	<u>coarse Sand &amp; gravel</u>	60	116
WELL LOCATION: sec. <u>1</u> T. <u>17</u> N R. <u>4</u> E S 4W <u>1</u> miles <u>East</u> of <u>Inverness</u> (distance) (direction) (nearest town)			
WELL PURPOSE: (home, irrigation, municipal, industrial)			
WELL COMPLETION DATA:			
(1) diameter (inches) <u>16"</u>			
(2) total depth (feet) <u>116'</u>			
(3) static water level (feet) <u>24'</u> <small>below above</small> top of ground.			
(4) casing <u>Steel</u> , <u>76'</u> (material) (depth)			
<u>    </u> If telescope see back. (size)			
(5) screen <u>40'</u> , <u>76'</u> (length) (depth to top)			
<u>12"</u> , <u>Steel</u> (size) (material)			
(6) pump <u>30</u> <u>1500</u> (HP) (yield gpm)			
<u>0</u> (type power)			
(7) electric log <u>No</u> (yes or no)			
<u>    </u> (organization running log)			
(8) how well bottom plugged <u>Steel Plate</u>			
DRILLERS REMARKS:			

CODED


DEPT. OF NATURAL RESOURCES  
BUREAU OF LAND & WATER RESOURCES

OCT 12 1984

RECEIVED

If well telescopes please sketch and show depths.

GROUND LEVEL

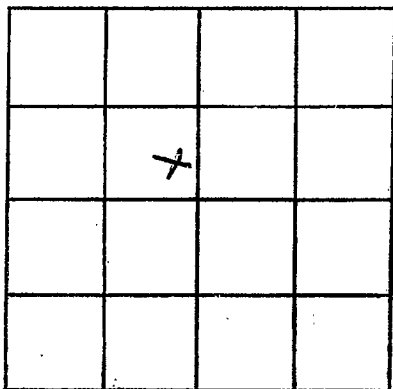

SECTION 1

Please indicate well location X.

ADDITIONAL INFORMATION

If more than one screen,  
show locations of each on sketch.