

MISSISSIPPI DEPARTMENT OF NATURAL RESOURCES

Bureau of Land and Water Resources

Southport Mall

P.O. Box 10631

Jackson, Mississippi 39209

WATER WELL DRILLERS LOG

CODED

~~SUNFLOWER HUMPHREYS~~
CL 2614 T69

SUNFLOWER HUMPHREYS

4/13 19 85 LAYNE-CENTRAL CO. date well completed firm name county well located

LANDOWNER:	description of formations encountered:	from	to
L.A. DAVIDSON			
ISOLA, MS	fine sand	22	32
(mailing address)	medium sand	32	42
	coarse sand	42	62
	pea gravel/coarse sand	62	124

WELL LOCATION:
sec. 32 T 17 N R 4 E
4 miles W of Isola
(distance) (direction) (nearest town)

CODED

WELL PURPOSE: irrigation
(home, irrigation, municipal, industrial)

- WELL COMPLETION DATA:
- (1) diameter (inches) 32"
 - (2) total depth (feet) 123'
 - (3) static water level (feet) 25' below top of ground.
 - (4) casing steel 73' (material), (depth), 18" If telescope see back. (size)
 - (5) screen 50' 73' (length), (depth to top) 16" st. steel (size), (material)
 - (6) pump 60 3000 (HP), (yield gpm) elec. (type power)
 - (7) electric log no (yes or no) (organization running log)
 - (8) how well bottom plugged st. plate


RECEIVED
JUL 8 - 1985

Department of Natural Resources
Bureau of Land & Water Resources

DRILLERS REMARKS:

If well telescopes please sketch and show depths.

GROUND LEVEL

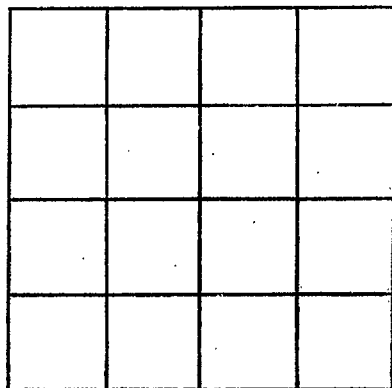

SECTION _____

Please indicate well location X.

ADDITIONAL INFORMATION

If more than one screen,
show locations of each on sketch.