

Sunflower
T 71
7-5-85

MISSISSIPPI DEPARTMENT OF NATURAL RESOURCES
Bureau of Land and Water Resources
Southport Mall
P.O. Box 10631
Jackson, Mississippi 39209
WATER WELL DRILLERS LOG

L
CODED

7-5-85 date well completed
19 Irrigation equipment Inc. firm name
Sunflower county well located

LANDOWNER: IRA Allen Anthony
Indianola Marie Road
Indianola, MS 38751
(mailing address)

| description of formations encountered | from | to |
|---------------------------------------|------|-----|
| CLAY | 0 | 15 |
| FINE SAND | 15 | 35 |
| COURSE SAND | 35 | 70 |
| COURSE SAND / PEA GRAVEL | 70 | 119 |

WELL LOCATION:
sec. 21 T. 17 N. R. 4 E
5 miles South of INVERNESS
(distance) (direction) (nearest town)

CODED

WELL PURPOSE: PIVOT
(home, irrigation, municipal, industrial)

- WELL COMPLETION DATA:
- (1) diameter (inches) 12"
 - (2) total depth (feet) 119
 - (3) static water level (feet) 20 below above top of ground.
 - (4) casing steel 79' (material) (depth)
 - (size) if telescope see back.
 - (5) screen 40' 79' (length) (depth to top)
 - (size) (material)
 - (6) pump 60 1200 (HP) (yield gpm)
 - (type power)
 - (7) electric log NO (yes or no)

(organization running log) steel plate
(8) how well bottom plugged


RECEIVED
JUL 26 1995

DRILLERS REMARKS:

If well telescopes please sketch and show depths.

IRRIGATION EQUIPMENT
601/887-2555
INDIANOLA, MS

GROUND LEVEL

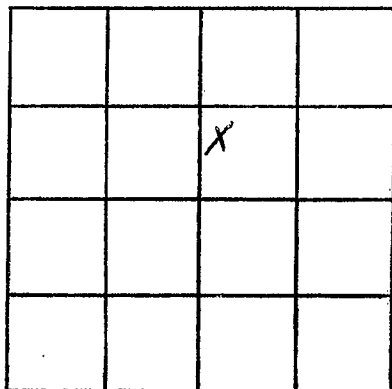

SECTION 21

Please indicate well location X.

ADDITIONAL INFORMATION

If more than one screen,
show locations of each on sketch.