

MISSISSIPPI DEPARTMENT OF NATURAL RESOURCES

Bureau of Land and Water Resources

Southport Mall

P.O. Box 10631

Jackson, Mississippi 39209

WATER WELL DRILLERS LOG

CODED

Sunflower  
T 72

May 27 1985 date well completed  
Lamp's Well & Pump firm name  
Sunflower county well located

LANDOWNER: Paul Townsend

description of formations encountered

from to

Belzoni, Mo.  
(mailing address)

CLAY	0	40
FINE SAND	40	60
COARSE SAND & GRAVEL	60	114

WELL LOCATION:

sec. 18 T 17 N R 4 E  
S 4 W  
3 1/2 miles IN of Coile  
(distance) (direction) (nearest town)

WELL PURPOSE: Fish Pond  
(home, irrigation, municipal, industrial)

CODED


WELL COMPLETION DATA:

- (1) diameter (inches) 12"
- (2) total depth (feet) 114'
- (3) static water level (feet) 24' <sup>below</sup> top of ground.
- (4) casing Steel, 74' (material) (depth)  
If telescope see back.  
(size)
- (5) screen 40' 74' (length) (depth to top)  
12" Steel (size) (material)
- (6) pump 60 3000 (HP) (yield gpm)  
0 (type power)
- (7) electric log no (yes or no)

(organization running log)


(8) how well bottom plugged Steel Plate

DRILLERS REMARKS:

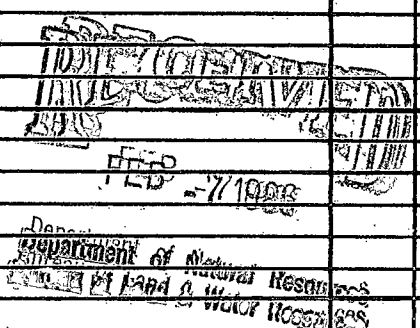

If well telescopes please sketch and show depths.

GROUND LEVEL

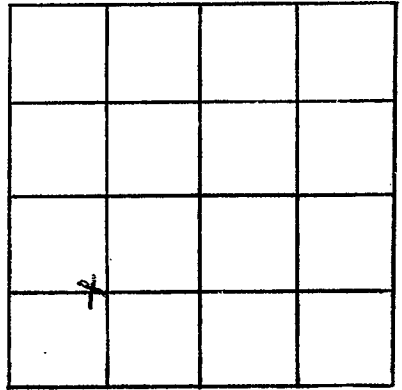

SECTION 18

Please indicate well location X.

ADDITIONAL INFORMATION

If more than one screen,  
show locations of each on sketch.