

MISSISSIPPI DEPARTMENT OF NATURAL RESOURCES

Bureau of Land and Water Resources

Southport Mall

P.O. Box 10631

Jackson, Mississippi 39209

WATER WELL DRILLERS LOG

CODED CODE

SUNFLOWER
T 73

July 22 1986 Lamps wells pump Sunflower
date well completed firm name county well located

LANDOWNER: Bill Jimmie

description of formations encountered

from to

chiveness no
(mailing address)

slay 0 30
fine sand 30 80
course 3 and gravel 80 125

WELL LOCATION:

sec. 22 T 17 N R 4 E
S W
1 miles W of Coile
(distance) (direction) (nearest town)

WELL PURPOSE: Fish Pond
(home, irrigation, municipal, industrial)

WELL COMPLETION DATA:


- (1) diameter (inches) 8"
- (2) total depth (feet) 125
- (3) static water level (feet) 26 below above top of ground.
- (4) casing PVC, 85'
(material) (depth)
(size) If telescope see back.
- (5) screen 40' 85'
(length) (depth to top)
8" PVC
(size) (material)
- (6) pump 10 700
(HP) (yield gpm)
elec
(type power)
- (7) electric log no
(yes or no)

(organization running log)

(8) how well bottom plugged PVC cap

DRILLERS REMARKS:

CODED

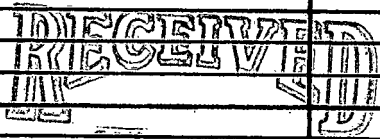


SEP 26 1986

Department of Natural Resources
Bureau of Land & Water Resources

If well telescopes please
sketch and show depths.

GROUND LEVEL

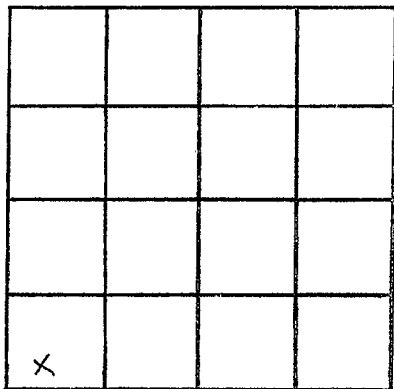

SECTION 22

Please indicate well location X.

ADDITIONAL INFORMATION

If more than one screen,
show locations of each on sketch.