

MISSISSIPPI DEPARTMENT OF NATURAL RESOURCES

Bureau of Land and Water Resources

Southport Mall

P.O. Box 10631

Jackson, Mississippi 39209

WATER WELL DRILLERS LOG

CODED

SUNFLOWER
86-225KSE-01
T 74

8-13 1986 Dyer Well, Inc Sunflower
 date well completed firm name county well located

LANDOWNER:	description of formations encountered	from	to
<u>Hartland Properties II</u> <u>P.O. Box 4812</u> <u>Greenville, Ms. 38701</u> (mailing address)			
<u>WELL LOCATION: NW 1/4 of SE 1/4</u> sec. <u>12</u> T. <u>17</u> N R. <u>4</u> E <u>3 1/2</u> miles <u>East</u> of <u>Inverness</u> (distance) (direction) (nearest town)	<u>fine sand</u>	<u>18</u>	<u>66</u>
<u>WELL PURPOSE: Irrigation</u> (home, irrigation, municipal, industrial)	<u>Sand + Gravel</u>	<u>66</u>	<u>108</u>
<u>WELL COMPLETION DATA:</u>			
(1) diameter (inches) <u>16"</u>			
(2) total depth (feet) <u>108 ft</u>			
(3) static water level (feet) <u>24</u> below above top of ground.			
(4) casing <u>Steel</u> , <u>68 ft.</u> (material) (depth) <u>16"</u> (size) if telescope see back.			
(5) screen <u>40'</u> , <u>68 ft.</u> (length) (depth to top) <u>16"</u> , <u>mild steel</u> (size) (material)			
(6) pump <u>40</u> <u>1800</u> (HP) (yield gpm) <u>Diesel</u> (type power)			
(7) electric log <u>NO</u> (yes or no) _____ (organization running log)			
(8) how well bottom plugged <u>Plate</u>			
<u>DRILLERS REMARKS:</u>			
<u>86-225KSE-01</u>			


CODED

RECEIVED
 105
 SEP 16 1986

Department of Natural Resources
 Bureau of Land & Water Resources

If well telescopes please sketch and show depths.

GROUND LEVEL

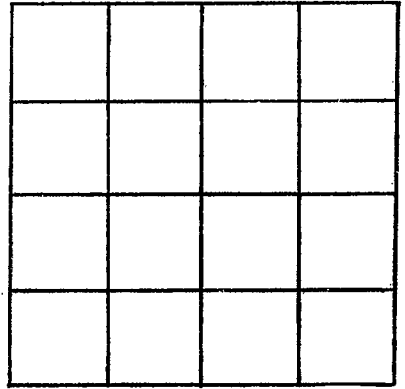

SECTION _____

Please indicate well location X.

ADDITIONAL INFORMATION

If more than one screen,
show locations of each on sketch.