

CODED

MISSISSIPPI DEPARTMENT OF NATURAL RESOURCES

Bureau of Land and Water Resources

COUNTY WELL LOCATED
Sunflower

WELL NUMBER **783** CODED

DATE WELL COMPLETED
6-30-88

PERMIT NUMBER

NAME OF DRILLING FIRM
IRRIGATION EQUIPMENT

601/887-2555
INDIANOLA, MS

P.O. Box 10631
Jackson, Mississippi 39209
WATER WELL DRILLERS LOG

NAME & MAILING ADDRESS OF LANDOWNER
W.W. Gholston

Hwy. 49 west

INVERNESS, MS 38753

WELL LOCATION: SEC **23** TOWNSHIP **17** RANGE **4**

DISTANCE **4** Miles **South** of **INVERNESS**

OTHER LANDMARK

WELL PURPOSE: Home, Irrigation, Municipal, Industrial, Fish Pond, etc.
IRRIGATION - PIVOT

PUMP DATA

PUMP TYPE (Circle One):
Submersible, Turbine Jet Flowing Well,
Other (Describe)

POWER TYPE (Circle One):
Electric, Tractor, Diesel, Gasoline, Butane,
Other (Describe) H/P

Pump Capacity (GPM) **1200** No. of Stages **3** Setting Depth **60** FT.

PUMP TEST

Well yielded _____ GPM with
a drawdown of _____ ft.
after _____ hours of pumping

WELL DATA

Well Depth 98'	Casing Diameter (In.) 12	Casing Length (Ft.) 58
Type of Casing Steel	Hole Depth 98	Depth to Static Water Level 30'

TYPE OF COMPLETION: (Circle One or More):
Gravel Packed Underreamed, Telescoped,
Natural Development, Open Hole, Other

Top of Lap Pipe or Reduction in Casing

FEET IF TELESCOPED OR MORE THAN ONE SCREEN: USE BACK PAGE

LOG DATA

TYPE OF LOG RUN (Circle One):
No Log Run, Electric, Gamma Ray, Density, Sonic, Neutron,
Other (Describe)

Name of Organization Running Log

SCREEN DATA

Diameter - Inches 12	Length - Feet 40	Slot Size - Inches .060
Screen Type Steel	Depth to Bottom - Feet 40	

GEOLOGIC DATA (Office Use Only)

Surface Elev.	Geologic Unit	Unit Thickness	Depth to Top
Subs. SWL	Date	Analysis	Aquifer Test

Driller's Remarks
#88-176-JLC-03
POINDEXTER


DESCRIPTION OF FORMATIONS ENCOUNTERED	FROM	TO	FORMATIONS (Continued)	FROM	TO
Clay	0	18	RECEIVED JUL 06 1988 Department of Natural Resources Bureau of Land & Water Resources		
Fine SAND	18	28			
COARSE SAND	28	38			
Clay	38	43			
Fine SAND	43	58			
COARSE SAND with gravel	58	95			
Clay	95	98			

IF MORE SPACE IS NEEDED, USE BACK

If well telescopes please sketch and show depths.

IRRIGATION EQUIPMENT
601/887-2555
INDIANOLA, MS

GROUND LEVEL

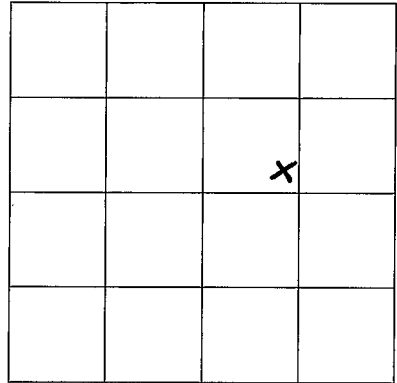

SECTION 23

Please indicate well location X.

ADDITIONAL INFORMATION

If more than one screen,
show location of each on sketch.