

MISSISSIPPI DEPARTMENT OF NATURAL RESOURCES
Bureau of Land and Water Resources

COUNTY WELL LOCATED
Sunflower

WELL NUMBER **188** CODED

DATE WELL COMPLETED
June 15 1988

PERMIT NUMBER

NAME OF DRILLING FIRM
Ranny's Well & Pump

CODED P.O. Box 10631
Jackson, Mississippi 39209
WATER WELL DRILLERS LOG

NAME & MAILING ADDRESS OF LANDOWNER
B.W. King

Inverness, Mo.

WELL LOCATION: SEC **17** TOWNSHIP **17** RANGE **4**
SW 1/4 NE 1/4 **S** **W**

DISTANCE **7** Miles DIRECTION **SW** of NEAREST TOWN **INVERNESS**

OTHER LANDMARK

WELL PURPOSE: Home, Irrigation, Municipal, Industrial, Fish Pond, etc.

PUMP DATA

PUMP TYPE (Circle One):
Submersible, Turbine, Jet, Flowing Well,
Other (Describe)

POWER TYPE (Circle One):
Electric, Tractor, Diesel, Gasoline, Butane,
Other (Describe)

Pump Capacity (GPM)	No. of Stages	Setting Depth
1500	3	50 FT.

PUMP TEST

Well yielded _____ GPM with
a drawdown of _____ ft.
after _____ hours of pumping

WELL DATA

Well Depth 116'	Casing Diameter (In.) 16"	Casing Length (Ft.) 76'
Type of Casing Steel	Hole Depth 116'	Depth to Static Water Level 20'

TYPE OF COMPLETION: (Circle One or More):
Gravel Pack, Underreamed, Telescoped,
Natural Development, Open Hole, Other

Top of Lap Pipe or Reduction in Casing
FEET IF TELESCOPED OR MORE THAN ONE SCREEN: USE BACK PAGE

LOG DATA

TYPE OF LOG RUN (Circle One): No Log Run,
Electric, Gamma Ray, Density, Sonic, Neutron,
Other (Describe)

Name of Organization Running Log

SCREEN DATA

Diameter - Inches 16"	Length - Feet 40'	Slot Size - Inches .060
Screen Type Steel	Depth to Bottom - Feet 116'	

GEOLOGIC DATA (Office Use Only)

Surface Elev.	Geologic Unit	Unit Thickness	Depth to Top
Subs. SWL	Date	Analysis	Aquifer Test

Driller's Remarks

RECEIVED


DESCRIPTION OF FORMATIONS ENCOUNTERED	FROM	TO	FORMATIONS (Continued)	FROM	TO
Clay	0	48	NOV 18 1988		
Fine sand	48	76			
Coarse sand & gravel	76	116			

Department of Natural Resources
Bureau of Land & Water Resources

IF MORE SPACE IS NEEDED, USE BACK

If well telescopes please
sketch and show depths.

GROUND LEVEL

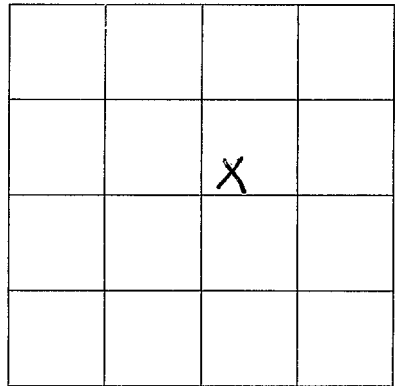

SECTION 17

Please indicate well location X.

ADDITIONAL INFORMATION

If more than one screen,
show location of each on sketch.