

MISSISSIPPI DEPARTMENT OF ENVIRONMENTAL QUALITY
Bureau of Land and Water Resources

147 *ED* P. O. Box 10631
Jackson, MS 39289-0631
WATER WELL DRILLERS LOG

COUNTY WELL LOCATED	
Sunflower	
WELL NUMBER	CODER
197	✓
DATE WELL COMPLETED	
7-9-92	

PERMIT NUMBER
NAME OF DRILLING FIRM
IRRIGATION EQUIPMENT
601/887-2555
INDIANOLA, MS

NAME & MAILING ADDRESS OF LANDOWNER		
Holly Ridge Planting		
P.O. Box 95		
Holly Ridge, MS 38749		
WELL LOCATION:	SEC	TOWNSHIP
	9	17
		RANGE
		4
DISTANCE	DIRECTION	NEAREST TOWN
3 Miles	SW	of Inverness
OTHER LANDMARK		
WELL PURPOSE: Home, Irrigation, Municipal, Industrial, Fish Pond, etc.		
Irrigation		

PUMP DATA		
PUMP TYPE (Circle One):		
<input checked="" type="radio"/> Submersible	<input type="radio"/> Turbine,	<input type="radio"/> Jet
Other (Describe) _____		
POWER TYPE (Circle One):		
<input checked="" type="radio"/> Electric	<input type="radio"/> Tractor,	<input type="radio"/> Gasoline,
Other (Describe) _____		
Pump Capacity (GPM)	No. of Stages	Setting Depth
1800	1	80
FT.		
PUMP TEST		
Well yielded _____ GPM with		
a drawdown of _____ ft.		
after _____ hours of pumping		

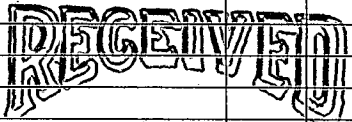
WELL DATA		
Well Depth	Casing Diameter (In.)	Casing Length (Ft.)
105	12	65
Type of Casing	Hole Depth	Depth to Static Water Level
steel	105	25'
TYPE OF COMPLETION: (Circle One or More):		
<input checked="" type="checkbox"/> Gravel Packed,	<input type="checkbox"/> Underreamed,	<input type="checkbox"/> Telescoped,
<input type="checkbox"/> Natural Development,	<input type="checkbox"/> Open Hole,	<input type="checkbox"/> Other
(Describe) _____		
Top of Lap Pipe or Reduction in Casing		
FEET <input type="checkbox"/> IF TELESCOPED OR MORE THAN ONE SCREEN: USE BACK PAGE		

LOG DATA	
TYPE OF LOG RUN (Circle One):	
<input type="checkbox"/> No Log Run,	<input type="checkbox"/> Electric, Gamma Ray, Density, Sonic, Neutron,
Other (Describe) _____	
Name of Organization Running Log	

SCREEN DATA		
Diameter - Inches	Length - Feet	Slot Size - Inches
12	40	.060
Screen Type	Depth to Bottom - Feet	
steel	105	

GEOLOGIC DATA (Office Use Only)			
Surface Elev.	Geologic Unit	Unit Thickness	Depth to Top
Subs. SWL	Date	Analysis	Aquifer Test
Driller's Remarks			

DESCRIPTION OF FORMATIONS ENCOUNTERED	FROM	TO
clay	0	15
Fine sand	15	45
medium sand	45	55
COARSE SAND + GRAVEL	55	105

FORMATIONS (Continued)	FROM	TO
 AUG 10 1992		
Dept. of Environmental Quality Bureau of Land & Water Resources		
IF MORE SPACE IS NEEDED, USE BACK		

