

# State Well Report

## Part 1

Mississippi Department of Environmental Quality  
 Office of Land and Water Resources  
 P.O. Box 10631  
 Jackson, MS 39289-0631  
 (601)961-5210  
 (601)354-6938 (fax)

For Office Use Only:

Aquifer: \_\_\_\_\_  
 Well #: T-117  
 L. S. Elevation: \_\_\_\_\_  
 E-log #: \_\_\_\_\_

County: Sunflower  
 Permit #: QW 39850  
 Irrigation Equipment  
 Driller: \_\_\_\_\_  
 Date drilling completed: 10-26-04

IRRIGATION EQUIPMENT, INC.

State Law requires that this report be prepared by the driller in detail and filed with the Department within 30 days of completion of drilling of the well.

Well Owner Information	Well Location
Owner Name: <u>Myers Farms</u>	Latitude: _____ Longitude: _____
Mailing Address: <u>Box 878</u>	Method of Lat/Long (circle one): <input type="radio"/> Conventional Survey, <input type="radio"/> USGS quad, <input type="radio"/> Hand-held GPS, <input type="radio"/> Survey-grade GPS
<u>Indianola, MS 38751</u>	<u>NW 1/4 SE 1/4 Sec 36 Twn 17N Rng 4W</u>
City: _____ State: _____ Zip Code: _____	Distance: <u>3</u> Miles Direction: <u>SE</u> of Nearest Town: <u>Caile</u>
Telephone No. ( <u>662-962-3761</u> )	

**Well Data**

Purpose of Well (circle one) Home Industrial Public Supply Irrigation Fish Culture Other Replacement

Date well drilling started: 10-26-04 Date well drilling completed: 10-26-04

If flowing, method of flow regulation: Valve \_\_\_\_\_ Other (describe) \_\_\_\_\_

Static Water Level: 35' feet above or below (circle one) land surface Date measured: 10-28-04

Method of Measurement (circle one) steel tape electric tape air line other: \_\_\_\_\_

Hole depth: 127' Well depth: 127' Well grouted to a depth of 10 feet

Type of grout (circle one): Cement Bentonite Mix

Casing length: 87' feet Casing diameter: 16 inches Type of casing: PVC Sch. 40

Screen length: 40' feet Screen diameter: 16 inches Type of screen: PVC Sch. 40

Screen slot size: .050 inches Setting depth: From 88 feet to 127 feet

Type of completion (circle all applicable): Gravel packed Underreamed Telescoped Open hole Natural Development  
 Other (describe): \_\_\_\_\_

Top of lap pipe or reduction in casing: \_\_\_\_\_ feet. If telescoped or more than one screen, describe on back of page

Logs run (circle all applicable): No log run Electric Gamma Ray Density Sonic Neutron Other: \_\_\_\_\_

Name of organization running log(s): \_\_\_\_\_

I certify that the well was drilled, constructed, and completed in accordance with all applicable requirements of the Mississippi Department of Environmental Quality and/or the Mississippi Department of Health regulations and state laws.  
 Irrigation Equipment Inc.  
 Patrick M. Chism 0695

Print Name of Water Well Contractor and License No.

Patrick M. Chism  
 Signature of Water Well Contractor

RECEIVED

NOV 08 2004  
 BY: OLWR

If well telescopes please sketch below and show depths.


Ground Level

T-117

Description of Formations Encountered	From	To
Clay	0	29
Fine Sand	30	35
Fine Sand/gravel	36	42
Med. Sand/gravel	43	127

If more than one screen, show location of each on sketch

Sketch the property layout and include the following: 1) the well location; 2) any permanent structures on the property that may aid in locating the well; 3) any roads, power lines, or other items that may aid in locating the property and the well; 4) indicate direction.

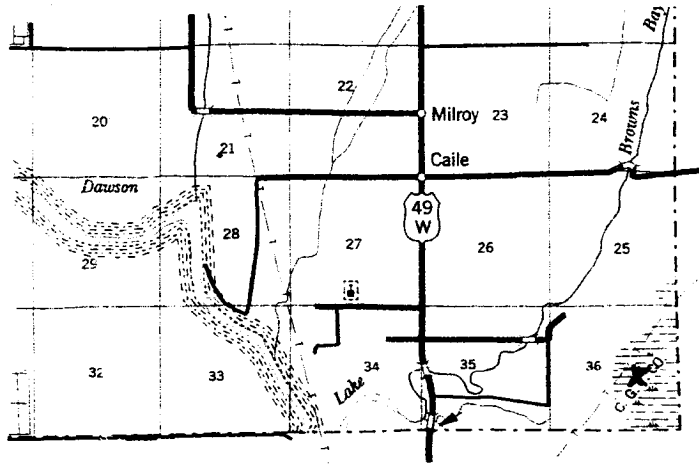

Landowner Name: Myers Farms

*Patrick M. Chuman*

Signature of Water Well Contractor

# STATE WELL REPORT

County: Sunflower  
 Permit #: GW-39850  
 Irrigation Equipment  
 Driller: \_\_\_\_\_  
 Date completed: 10-28-04

**Part 2**  
**Pump Installer's Completion Report**  
 Mississippi Department of Environmental Quality  
 Office of Land and Water Resources  
 P.O. Box 10631  
 Jackson, MS 39289-0631  
 (601)961-5210  
 (601)354-6938 (fax)

**For Office Use Only:**

Aquifer: \_\_\_\_\_  
 Well #: T-117  
 Elevation: \_\_\_\_\_

This report should be prepared by the pump installer in detail and filed with the Department within 30 days of the installation of pump.

Well Owner Information	Well Location
Owner Name: <u>Myers Farms</u>	Latitude: _____ Longitude: _____
Mailing Address: <u>Box 878</u>	Method of Lat/Long (circle one): <input type="radio"/> Conventional Survey,
<u>Indianola, MS 38751</u>	<input type="radio"/> USGS quad, <input type="radio"/> Hand-held GPS, <input type="radio"/> Survey-grade GPS
City                      State                      Zip Code	NW $\frac{1}{4}$ SE $\frac{1}{4}$ Sec <u>36</u> Twn <u>17N</u> Rng <u>4W</u>
<u>662-962-3761</u>	Distance                      Direction                      Nearest Town
Telephone No. (____) _____	<u>3</u> Miles <u>SE</u> of <u>Caile</u>

Pump Type Circle one	Power Type Circle one
Air Lift                      Jet                      Submersible	Diesel Engine                      Gasoline Engine                      Natural Gas
Bucket                      Piston <u>Turbine</u>	<u>Electric Motor</u> Hand                      Tractor PTO
Centrifugal                      Rotary                      Flowing Well	Windmill                      Other (specify): _____
Other (specify): _____	Horse Power Rating of Motor: <u>60</u>
Date Pump Installed: <u>10-28-04</u>	Setting Depth: <u>80</u> feet
Rated Pump Capacity: <u>2500-3000</u> Gallons Per Minute	Number of Stages: <u>1</u>

Pump Test Data	Method of Measuring Water Level Circle one
Date Well Tested: _____	Air Line                      Electric Measuring Line                      Steel Tape
Static Water Level (A): _____ Feet Below Land Surface	Other (specify): _____
Pumping Water Level (B): _____ Feet Below Land Surface	For flowing well, measured shut in head: _____ feet
Drawdown [(B) - (A)]: _____ Feet Below Land Surface	Well yielded _____ GPM with a drawdown of
Test Pumping Rate: _____ Gallons Per Minute	_____ feet after _____ hours of pumping
Duration of Pump Test (minimum 4 hours): _____ hours	

I HEREBY CERTIFY that the above statements are true to the best of my knowledge.

Patrick M. Chism 0695                      Patrick M. Chism  
 Print Name of Pump Installer and License No. (if applicable)                      Signature of Pump Installer

RECEIVED  
 NOV 08 2004  
 BY: OLWR