County:	Sunflo	wer		
Permit#: 60 408/7 Irrigation Equipmen				
Date drill	ing completed:	1-9-06		

State Well Report

Part 1

Mississippi Department of Environmental Quality
Office of Land and Water Resources
P.O. Box 10631
Jackson, MS 39289-0631
(601)961-5210
(601)354-6938 (fax)

For Office Use Only:	
Aquifer:	
Well #: <u>T- 124</u>	
L. S. Elevation:	
E-log #:	

State Law requires that this report be prepared by the driller in detail and filed with the Department within 30 days of completion of drilling of the well.

30 days of completion of drilling of the well.					
Well Owner Information	Well Location				
Sunflower County Superintendent Of Owner Name_Education	Latitude: 33.19 07.6N ongitude 90 37 01.7W				
Mailing Address: 200 Main St.	Method of Lat/Long (circle one): Conventional Survey,				
	USGS quad, Hand-held GPS, Survey-grade GPS				
Indianola, MS 38751	NE 1/4 SW 1/4 Sec 16 Twn 17N Rng 4W				
City State Zip Code	Distance Direction Nearest Town				
Telephone No. ()	3 Miles SW of Inverness				
Well I	Data				
Purpose of Well (circle one) Home Industrial Public Supply	Urigation Fish Culture Other:				
If flowing, method of flow regulation: Valve Other (d					
Static Water Level: 33 feet above or below (circle one) l	and surface Date measured: 1-10-06				
Method of Measurement (circle one) steel tape electric tape	air line other:				
Hole depth: 125 Well depth: 125' Well grouted to a depth of 10 feet					
Type of grout (circle one): Cement Bentonite Mix					
Casing length: 85 feet Casing diameter: 10	inches Type of casing: _PVC				
Screen length: 40 feet Screen diameter: 10	inches Type of screen:PVC				
Screen slot size:inches Setting depth: From	86 <u>feet to 125</u> feet				
Type of completion (circle all applicable): Gravel packed Under	reamed Telescoped Open hole Natural Development				
Other (describe):					
Top of lap pipe or reduction in casing: feet. If tel	lescoped or more than one screen, describe on back of page				
Logs run (circle all applicable): (No log run) Electric Gamma Ray	Density Sonic Neutron Other:				
Name of organization running log(s):					
I certify that the well was drilled, constructed, and completed in a	eccordance with all applicable requirements of the Mississippi				
Department of Environmental Quality and/or the Mississippi Dep	partment of Health regulations and state laws.				
Irrigation Equipment Inc.	DLI mal				
Patrick M. Chism 0695	Total // Chan				
Print Name of Water Well Contractor and License No.	Signature of Water Well Contractor				

Farmer: Anthony Farms

49 Grace Road

Inverness, MS 38753

662-265-5561

RECEIVED


JAN 27 2006

BY: OLWR

Ground Level

Description of Formations Encountered	From	To
Clay	0	47
Fine Sand	48	55
Fine Sand/gravel Med. Sand/gravel	56 80	79
Med. Sand/gravel	180	125
		$oxed{oxed}$
	L	
	<u></u>	
	<u> </u>	
		ļ
	Ţ	
	T	
	1	
	1	T

If more than one screen, show location of each on sketch

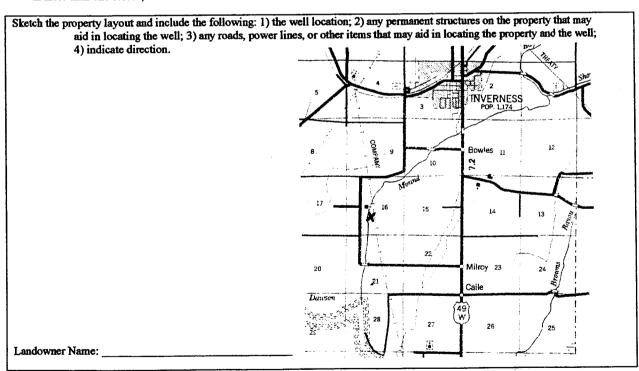

Signature of Water Well Contractor

STATE WELL REPORT

Part 2

County: Sunflower

Date completed:

Permit#: 60 40817

rrigation Equipment

1-10-06

Pump Installer's Completion Report Mississippi Department of Environmental Quality Office of Land and Water Resources P.O. Box 10631 Jackson, MS 39289-0631 (601)961-5210 (601)354-6938 (fax)

For Office Use Only:		
Aquifer:		
Well #:		

This report should be prepared by the pump installer in detail and filed with the Department within 30 days of the installation of pump.				
Well Owner Information Sunflower County Superintendent Owner Name: Of Education	Well Location Latitude: Longitude:			
Mailing Address: 200 Main St.	Method of Lat/Long (circle one): Conventional Survey,			
Indianola MS 38751 City State Zip Code Telephone No. ()	USGS quad, Hand-held GPS, Survey-grade GPS NE 1/4 SW 1/4 Sec 16 Twn 17NRng 4W Distance Direction Nearest Town 3 Miles SW of Inverness			
Pum p Type Circle one	Power Type Circle one			
Air Lift Jet Submersible	Diesel Engine Gasoline Engine Natural Gas			
Bucket Piston Turbine	Electric Motor Hand Tractor PTO			
Centrifugal Rotary Flowing Well	Windmill Other (specify):			
Other (specify):	Horse Power Rating of Motor: 15			
Date Pump Installed: 1-10-06	Setting Depth: 60 feet			
Rated Pump Capacity: 750 Gallons Per Minute	Number of Stages:1			
Pump Test Data	Method of Measuring Water Level Circle one			
Date Well Tested:	Air Line Electric Measuring Line Steel Tape			
Static Water Level (A): 33' Feet Below Land Surface	Other (specify):			
Pumping Water Level (B):Feet Below Land Surface				
Drawdown [(B) - (A)]:Feet Below Land Surface	For flowing well, measured shut in head:feet			
Test Pumping Rate: Gallons Per Minute Well yielded GPM with a drawdown of				
Duration of Pump Test (minimum 4 hours):hourshourshours of pumping				

I HEREBY CERTIFY that the above statements are true to the best of my knowledge Patrick M. Chism 0695 Print Name of Pump Installer and License No. (if applicable) Signature of Pump Installer

RECEIVED