	State Well	l Report	For Office Has Only
County: Sunflower	Part 1		For Office Use Only:
	Mississippi Department of		Aquifer:
Permit#:	Office of Land and Water Resources		Well #: 7- 126
Driller:	1.0. Dox	P.O. Box 10631	
Date drilling completed: $9-8-06$		n, MS 39289-0631 L. S. Elevation: 01)961-5210 )354-6938 (fax) E-log #:	
Date trining completes.	1 '		
	•	` '	
State Law requires that this rep		ller in detail and filed w	ith the Department within
30 days of completion of drilling		X 7 7	TT
Well Owner Informa	· ·		Location
Owner Name Robertson Pla	nting L	atitude: 33 .19 43.0	Longitude: 90 • 39 · 10 . 4
Mailing Address: 301 Camellia	Lane M	ethod of Lat/Long (circle or	
			GPS, Survey-grade GPS
	j	W 1/4 NE 1/4 Sec 18	Twn 17N Rng 4W
<u>Indianola M</u> City Sta	is 38751 🗔	JE NW	
	•	istance Direction Miles SW	Nearest Town of Inverness
662-887-2760	)	- IATHES	VI
	Well Date		11-7-05
Purpose of Well (circle one) Home Inc	Justrial Public Supply	rigation Fish Culture	Replacement
•			
Date well drilling started: $9-8-$	Date well	drilling completed:	9-8-00
f flowing, method of flow regulation: Va			
Static Water Level: 34 feet a	bove of below circle one) land	surface Date measured:	9-11-06
Method of Measurement (circle one)	teel tape electric tape	air line other:	
Hole depth: 111' Well de	pth: 111'	Well grouted to a depth of _	10 feet
Type of grout (circle one): Cement	Bentonite Mix		
Casing length: 71 feet Casi	ng diameter: 10	nches Type of casing: _	PVC 160
	4.0	1	PVC 160
<del>-</del>	een diameter: 10 i	nches Type of screen:	
Screen slot size: . 050 inches	Setting depth: From	72feet to	111 feet
Type of completion (circle all applicable)	: Gravel packed Underrea	med Telescoped Oper	n hole Natural Development
	Other (describe):		
Top of lap pipe or reduction in casing:	feet. If teleso	coped or more than one sc	reen, describe on back of page
Logs run (circle all applicable): No log r	nn Electric Gamma Ray I	Density Sonic Neutron	Other:
Name of organization running log(s):			
I certify that the well was drilled, const	ructed, and completed in acc	ordance with all applicabl	e requirements of the Mississippi
Department of Environmental Quality	and/or the Mississippi Depar	tment of Health regulation	ns and state laws.
Irrigation Equip	ment Inc.	(1) \( \frac{1}{2} \)	
Patrick M. Chism	0695	Val. 1	11 Uh.

Print Name of Water Well Contractor and License No.

**RECEIVED** 

Signature of Water Well Contractor

SEP 2 5 2006


BY: OLWA

If well telescopes please sketch below and show depths.

Ground Level

Desc	cription of Formations Encountered	From To
Clay		0 21
Fine	Sand	22 35
Fine	Sand/gravel	36 52
Med	Sand/gravel Sand/gravel	53 111
L		
	A STATE OF THE STA	
		<del></del>
<u> </u>		
<del>                                     </del>		
<b></b>		

If more than one screen, show location of each on sketch

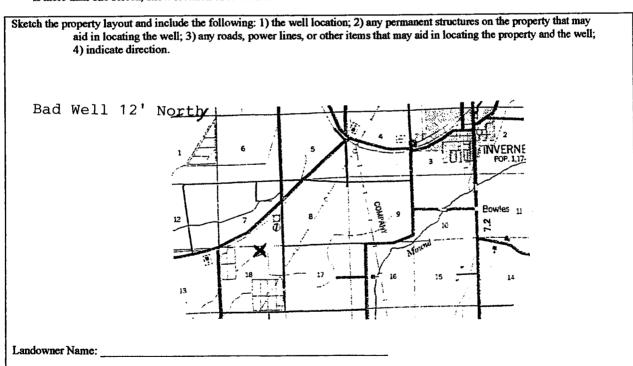

Signature of Water Well Contractor

## STATE WELL REPORT

## County: Sunflower Pamit#: gation Equipment 9-8-06

## Part 2 Pump Installer's Completion Report Mississippi Department of Environmental Quality Office of Land and Water Resources

For Office Use Only:				
Aquifer:	•			
well #:	- 126			
Elevation:				

Driller: P.O. Box 10631 Jackson, MS 39289-0631 Date completed: (601)961-5210 (601)354-6938 (fax) Copy information from block on Part 1 This part of the report must be completed by a licensed water well contractor or a licensed pump installer. A copy of Part 1 of the report must be attached and both parts filed with the Department at the above address within 30 days of well completion. Well Location Well Owner Information Owner Name: Robertson Planting Longitude: 301 Camellia Lane Method of Lat/Long (check one): Conventional Survey\_\_\_\_, Mailing Address: USGS quad\_\_\_\_, Hand-held GPS\_\_\_, Survey-grade GPS\_\_\_ Indianola MS 38751 NW 1/4 NE 1/4 Sec 18 T 17N R 4W State Zip Code City Direction Nearest Town Distance of Inverness Miles SW Telephone No. (\_\_\_\_\_\_ Power Type Pump Type Circle one Circle one Natural Gas Gasoline Engine Submersible Diesel Engine Air Lift Jet Tractor PTO Electric Motor Turbine Hand Bucket Piston Other (specify): \_ Flowing Well Windmill Centrifugal Rotary Horse Power Rating of Motor: \_\_\_\_\_\_15 Other (specify): \_\_\_\_\_ Setting Depth: 70 feet 9-11-06 Date Pump Installed: \_\_\_\_ Rated Pump Capacity: 750 Number of Stages: Gallons Per Minute Method of Measuring Water Level **Pump Test Data** Circle one Date Well Tested: \_\_\_ Electric Measuring Line Steel Tape Air Line Static Water Level (A): \_\_\_\_\_ Feet Below Land Surface Other (specify): Pumping Water Level (B): Feet Below Land Surface For flowing well, measured shut in head: \_\_\_\_\_feet Drawdown [(B) - (A)]: \_\_\_\_\_\_Feet Below Land Surface Well yielded \_\_\_\_\_GPM with a drawdown of Test Pumping Rate: \_\_\_\_\_ Gallons Per Minute feet after hours of pumping Duration of Pump Test (minimum 4 hours): hours

I HEREBY CERTIFY that the above statements are true to the best of my knowledge.				
Patrick M. Chism 0695	Taket 11 Chr Draw	_		
Print Name of Pump Installer and License No. (if applicable)	Signature of Pump Installer Form: OLWR-SVR-15	4FI		
	Form: OLWR-SWR-15			

SEP 2 5 2006 BY: OLWR