

MISSISSIPPI DEPARTMENT OF NATURAL RESOURCES

Bureau of Land and Water Resources

Southport Mall

P.O. Box 10631

Jackson, Mississippi 39209

WATER WELL DRILLERS LOG


SUNFLOWER
T2000

5-16-86
date well completed

IRRIGATION EQUIPMENT
firm name

SUNFLOWER
county well located

LANDOWNER: <u>Edward COBB</u>	description of formations encountered	from	to
<u>Rt. 2, BOX 196</u>			
<u>ISOLA, MS 38754</u> (mailing address)	<u>Fine sand</u>	<u>25</u>	<u>40</u>
<u>WELL LOCATION:</u>	<u>Coarse sand / pea gravel</u>	<u>40</u>	<u>110</u>
sec. <u>28</u> T. <u>17</u> N. R. <u>4</u> E. S. W.			
<u>1</u> miles <u>West</u> of <u>CAILE</u> (distance) (direction) (nearest town)			
<u>WELL PURPOSE: Fish Pond</u> (home, irrigation, municipal, industrial)			
<u>WELL COMPLETION DATA:</u>			
(1) diameter (inches) <u>10"</u>			
(2) total depth (feet) <u>110</u>			
(3) static water level (feet) <u>28</u> <u>below</u> top of ground. above			
(4) casing <u>PVC</u> <u>70'</u> (material) (depth)			
<u>10"</u> (size) If telescope see back.			
(5) screen <u>40'</u> <u>70'</u> (length) (depth to top)			
<u>10"</u> <u>PVC</u> (size) (material)			
(6) pump <u>10</u> <u>1000</u> (HP) (yield gpm)			
<u>Electric</u> (type power)			
(7) electric log <u>NO</u> (yes or no)			
(organization running log) <u>PVC CAP</u>			
(8) how well bottom plugged			

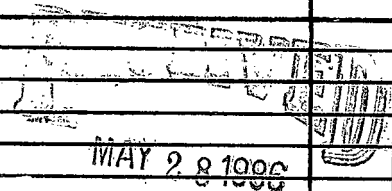

DRILLERS REMARKS:
86129KSE 01

Department of Natural Resources
Bureau of Land and Water Resources

If well telescopes please
sketch and show depths.

IRRIGATION EQUIPMENT
601/887-2555
INDIANOLA, MS

GROUND LEVEL

			X

SECTION 28

Please indicate well location X.

ADDITIONAL INFORMATION

If more than one screen,
show locations of each on sketch.