

MISSISSIPPI DEPARTMENT OF NATURAL RESOURCES

Bureau of Land and Water Resources

Southport Mall

P.O. Box 10631

Jackson, Mississippi 39209

WATER WELL DRILLERS LOG

SUNFLOWER  
T2001

5-17-86  
date well completed

IRRIGATION EQUIPMENT  
firm name

SUNFLOWER  
county well located

LANDOWNER: Edward COBB  
RT. 2, BOX 196  
ISOLA, MS 38754  
(mailing address)

description of formations encountered	from	to
clay	0	25
Fine sand	25	45
coarse sand	45	60
Fine sand	60	65
coarse sand/pea gravel	65	110

WELL LOCATION:  
sec. 28 T 17 N R 4 E  
S W  
1 miles West of CAILE  
(distance) (direction) (nearest town)

WELL PURPOSE: FISH POND  
(home, irrigation, municipal, industrial)

- WELL COMPLETION DATA:
- (1) diameter (inches) 10"
  - (2) total depth (feet) 110'
  - (3) static water level (feet) 28' <sup>below</sup> above top of ground.
  - (4) casing PVC 70' (material) (depth)  
10" (size) if telescope see back.
  - (5) screen 40' 70' (length) (depth to top)  
10" PVC (size) (material)
  - (6) pump 10 600 (HP) (yield gpm)  
Electric (type power)
  - (7) electric log NO (yes or no)
  - (8) how well bottom plugged PVC CAP

DRILLERS REMARKS:  
#86135 KSE01


RECEIVED  
MAY 28 1986

1986 Department of Natural Resources  
Bureau of Land & Water Resources

If well telescopes please sketch and show depths.

IRRIGATION EQUIPMENT,  
601/887-2555  
INDIANOLA, MS

GROUND LEVEL

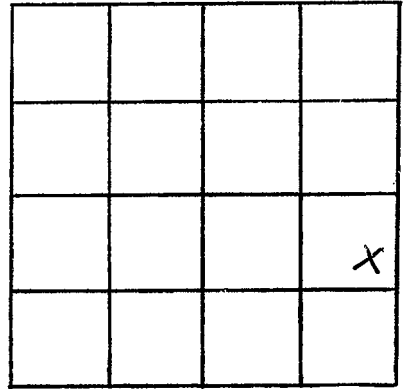

SECTION 28

Please indicate well location X.

ADDITIONAL INFORMATION

If more than one screen,  
show locations of each on sketch.