

MISSISSIPPI DEPARTMENT OF NATURAL RESOURCES
Bureau of Land and Water Resources

P.O. Box 10631
Jackson, Mississippi 39209
WATER WELL DRILLERS LOG

COUNTY WELL LOCATED <i>Sunflower</i>	
WELL NUMBER <i>1</i>	CODED
DATE WELL COMPLETED <i>2010</i> <i>7-16-90</i>	

PERMIT NUMBER
NAME OF DRILLING FIRM <i>Dyn Well</i>

NAME & MAILING ADDRESS OF LANDOWNER <i>Holly Ridge Ranch Inc.</i> <i>P.O. Box 95</i> <i>Holly Ridge, Ms. 38749</i>		
WELL LOCATION: SEC	TOWNSHIP	RANGE
<i>9</i>	<i>17</i>	<i>4</i>
	<i>N</i>	<i>W</i>
DISTANCE	DIRECTION	NEAREST TOWN
_____ Miles	_____ of _____	
OTHER LANDMARK		
WELL PURPOSE: Home, <u>Irrigation</u> , Municipal, Industrial, Fish Pond, etc.		

PUMP DATA		
PUMP TYPE (Circle One): Submersible, <u>Turbine</u> , Jet, Flowing Well, Other (Describe) _____		
POWER TYPE (Circle One): Electric, Tractor, <u>Diesel</u> , Gasoline, Butane, Other (Describe) _____ H/P _____		
Pump Capacity (GPM)	No. of Stages	Setting Depth
		<i>60</i> FT.
PUMP TEST		
Well yielded _____ GPM with a drawdown of _____ ft. after _____ hours of pumping		

WELL DATA		
Well Depth <i>112'</i>	Casing Diameter (In.) <i>16"</i>	Casing Length (Ft.) <i>72'</i>
Type of Casing <i>steel</i>	Hole Depth	Depth to Static Water Level
TYPE OF COMPLETION: (Circle One or More): <u>Gravel Packed</u> , Underreamed, Telescoped, Natural Development, Open Hole, Other (Describe) _____		
Top of Lap Pipe or Reduction in Casing		
FEET	IF TELESCOPED OR MORE THAN ONE SCREEN: USE BACK PAGE	

LOG DATA	
TYPE OF LOG RUN (Circle One): <u>No Log Run</u> Electric, Gamma Ray, Density, Sonic, Neutron, Other (Describe) _____	
Name of Organization Running Log <i>None</i>	

SCREEN DATA		
Diameter - Inches <i>16"</i>	Length - Feet <i>40'</i>	Slot Size - Inches <i>.030</i>
Screen Type <i>Wire Wraps</i>	Depth to Bottom - Feet	

GEOLOGIC DATA (Office Use Only)			
Surface Elev.	Geologic Unit	Unit Thickness	Depth to Top
Subs. SWL	Date	Analysis	Aquifer Test


Driller's Remarks
RECEIVED
OCT 26 1990

DESCRIPTION OF FORMATIONS ENCOUNTERED	FROM	TO	FORMATIONS (Continued)	FROM	TO
<i>Clay</i>	<i>0</i>	<i>42</i>	Department of Natural Resources Bureau of Land & Water Resources		
<i>Fine Sand</i>	<i>42</i>	<i>47</i>			
<i>Fine Sand + Gravel</i>	<i>47</i>	<i>98</i>			
<i>Fine Sand</i>	<i>98</i>	<i>104</i>			
<i>M Sand + Gravel</i>	<i>104</i>	<i>110</i>			
<i>Sand + Gravel</i>	<i>110</i>	<i>112</i>			

IF MORE SPACE IS NEEDED, USE BACK

If well telescopes please
sketch and show depths.

GROUND LEVEL

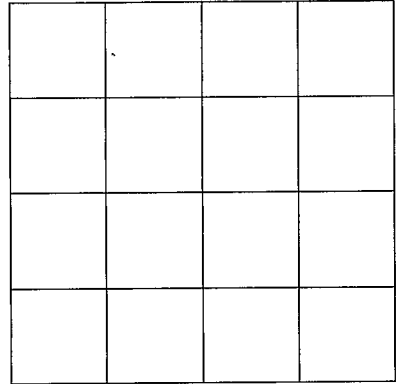

SECTION _____

Please indicate well location X.

ADDITIONAL INFORMATION

If more than one screen,
show location of each on sketch.