

Sunflower
T 2040
5-13-80

MISSISSIPPI
BOARD OF WATER COMMISSIONERS
416 North State Street
Jackson, Mississippi 39201

WATER WELL DRILLERS LOG

March 6 1980 Harry's Well Pump Sunflower
date well completed firm name county well located

LANDOWNER: Paul Moon
Isola Miss.
(mailing address)

WELL LOCATION:
sec. 35 T 17 N R 4 E S W
2 miles N.E. of ISOLA
(distance) (direction) (nearest town)

WELL PURPOSE: Irrigation
(home, irrigation, municipal, industrial)

- WELL COMPLETION DATA:
- (1) diameter (inches) 10"
 - (2) total depth (feet) 114'
 - (3) static water level (feet) 20' below top of ground.
 - (4) casing steel, 75' (material) (depth)
 - (size) if telescope see back.
 - (5) screen 40' 74' (length) (depth to top)
 - 10" steel (size) (material)
 - (6) pump 3 1/2 HP 300-500 (HP) (yield gpm)
 - Electric (type power)
 - (7) electric log (yes or no)
 - (organization running log)
 - (8) how well bottom plugged steel plate

description of formations encountered	from	to
clay	0'	20'
fine sand	20'	35'
med sand	35'	50'
coarse sand	50'	83'
coarse sand & gravel	83'	114'

DRILLERS REMARKS:


DEPT. OF NATURAL RESOURCES
BUREAU OF LAND & WATER RESOURCES

MAY 12 1980

RECEIVED

If well telescopes please sketch and show depths.

GROUND LEVEL

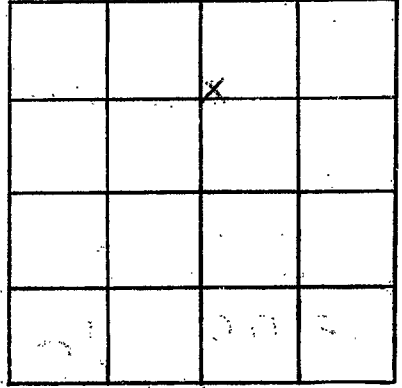

SECTION 35

Please indicate well location X.

ADDITIONAL INFORMATION

If more than one screen,
show locations of each on sketch.