

SUNF. MISSISSIPPI BOARD OF WATER COMMISSIONERS

U3

5-14-57

WATER WELL DRILLERS LOG

CODED 7/24/65

411

Date: May 14, , 1957 , Driller: Layne-Central Company County Sunflower

(Name)

(1) Owner of Land: W. F. Fleet
 (Name)
Inverness, Mississippi
 (Address)

(2) Location: 1/4, 1/4, Sec. 6 T17R3,
4 miles east of Inverness
 (distance) (direction) (Nearest Town)

(3) Topography: flat
 (Hilly) (Flat) (Level)

(4) Purpose of Well: irrigation
 (Domestic Irrigation
 Municipal, Industrial, Other)

Description & Color of Materials Sand, Clay, Red Clay, Shell, etc.	Thick- ness Feet	Depth Feet
Clay	5	5
Blue clay	31	36
Fine blue sand	17	53
Medium sand	11	64
Coarse sand	8	72
Coarse sand, clay balls & lignite	3	75
Coarse sand, pea gravel	10	82
Coarse sand, big rock	30	112

Information upon completion of well:

(1) Diameter 12 inches.

(2) Total Depth 112 feet.

(3) Water Level 20' 2" feet below top of ground.

(4) Cased to 82' 10", Size 12"

(5) Screen: Size 12", Length 30'

(6) Were any formations sealed against pollution?
no yes, no no.

If YES depth of formation _____


Why _____

Drillers Remarks: _____

2 1421 GPM.

Engine drive.

CODED

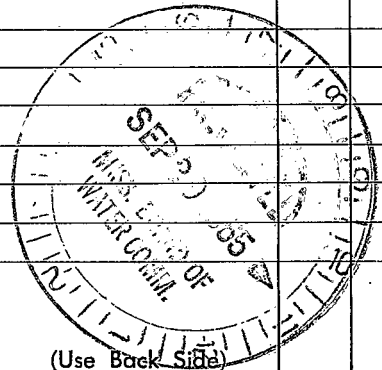

Well No.

(Use Back Side)

