

04
5-14-64

WATER WELL DRILLERS LOG

CODED

Driller: 5-14, 1964, Driller Five County Farmers County Sunflower
(Name ann)

(1) Owner of Land: STOVALL Farms
(Name)
STOVALL MISS
(Address)

(2) Location: 1/4, 1/4, Sec. 7 T17 R3
1 1/2 miles South East of INVERNESS
(distance) (direction) (Nearest Town)

(3) Topography: Flat
(Hilly) (Flat) (Level)

(4) Purpose of Well: Investigation
(Domestic Irrigation
Municipal, Industrial, Other)

Description & Color of Materials Sand, Clay, Red Clay, Shell, etc.	Thick- ness Feet	Depth Feet
<u>Buckshot + Blue mud</u>	<u>27</u>	<u>27 1/2</u>
<u>Blue mud + fine</u>		
<u>sand 27 1/2 to 40 1/2</u>		<u>40 1/2</u>
<u>fine sand 40 1/2 to 47</u>	<u>6 1/2</u>	<u>47</u>
<u>Coarse sand + small</u>		
<u>gravel 47 - 73</u>	<u>26</u>	<u>73</u>
<u>Coarse sand 73 - 79 1/2</u>	<u>6 1/2</u>	<u>79 1/2</u>
<u>Coarse sand +</u>		
<u>large gravel 79 1/2 - 92</u>	<u>12 1/2</u>	<u>92</u>
<u>Coarse sand +</u>		
<u>fine gravel 92 -</u>		
<u>to 100 1/2</u>	<u>8 1/2</u>	<u>100 1/2</u>

Information upon completion of well:

(1) Diameter 14 inches.

(2) Total Depth 100 feet.

(3) Water Level 11 feet below top of ground.

(4) Cased to 52, Size 14.

(5) Screen: Size 14, Length 48.


(6) Were any formations sealed against pollution?
_____ yes, _____ no.

CODED

If YES depth of formation _____

Why _____

Drillers Remarks: _____

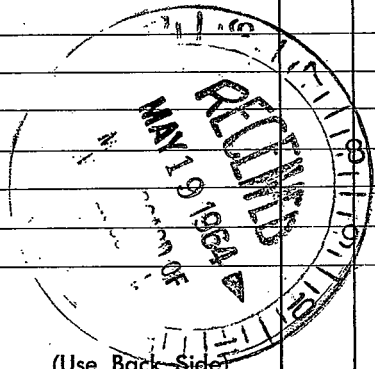

(Use Back Side)

Well No.

