

MISSISSIPPI DEPARTMENT OF NATURAL RESOURCES
 Bureau of Land and Water Resources
 Southport Mall
 P.O. Box 10631
 Jackson, Mississippi 39209
WATER WELL DRILLERS LOG

CODED

Sunflower
U 6
7/17/80

7/17/80 19 Larry's well & Pump Sunflower
 date well completed firm name county/well located

LANDOWNER: A. J. Ward

description of formations encountered	from	to
	clay	0
med sand	20	60
coarse sand	60	108

INVERNESS MS
 (mailing address)

WELL LOCATION:
 sec. 4 T. 17 N. R. 3 E.
5 miles East of Inverness
 (distance) (direction) (nearest town)

WELL PURPOSE: SPR
 (home, irrigation, municipal, industrial)

WELL COMPLETION DATA:

- (1) diameter (inches) 12"
- (2) total depth (feet) 108'
- (3) static water level (feet) 18' below above
top of ground.
- (4) casing Steel, 68'
(material) (depth)
- (size) If telescope see back.
- (5) screen 40', 68'
(length) (depth to top)
- 12", Steel
(size) (material)
- (6) pump 40, 2000
(HP) (yield gpm)
- gas
(type power)
- (7) electric log No
(yes or no)
- (organization running log)

(8) how well bottom plugged Steel Plate

DRILLERS REMARKS:

CODED


DEPT. OF NATURAL RESOURCES
 BUREAU OF LAND & WATER RESOURCES

APR 28 1981

RECEIVED

If well telescopes please
sketch and show depths.

GROUND LEVEL

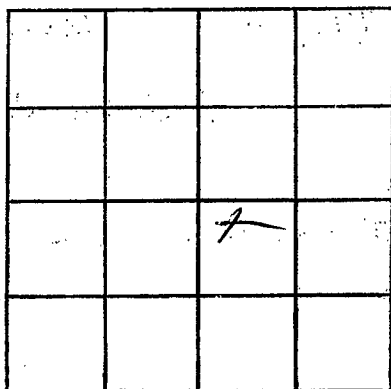

SECTION 4

Please indicate well location X.

ADDITIONAL INFORMATION

If more than one screen,
show locations of each on sketch.