

MISSISSIPPI DEPARTMENT OF NATURAL RESOURCES

Bureau of Land and Water Resources

Southport Mall

P.O. Box 10631

Jackson, Mississippi 39209

WATER WELL DRILLERS LOG

CODED

Sunflower  
117  
5-1-81

5-1 1981 date well completed      Deep Well? Inc. firm name      Sunflower county well located

LANDOWNER: Peter Myers  
Isola, MS.  
(mailing address)


WELL LOCATION:  
sec. 35 T. 10N S. R. 3 E. W  
3 miles NE of Isola  
(distance) (direction) (nearest town)

WELL PURPOSE: ISOLA  
(home, irrigation, municipal, industrial)

- WELL COMPLETION DATA:
- (1) diameter (inches) 16"
  - (2) total depth (feet) 133
  - (3) static water level (feet) 24 below above top of ground.
  - (4) casing Steel 93'  
(material) (depth)  
16" if telescope see back.  
(size)
  - (5) screen 40' 93'  
(length) (depth to top)  
16" Steel  
(size) (material)
  - (6) pump 60 3000  
(HP) (yield gpm)  
DIESEL  
(type power)
  - (7) electric log No  
(yes or no)  
(organization running log)
  - (8) how well bottom plugged Plate

description of formations encountered	from	to
clay	13	23
clay	23	33
clay	33	43
clay	43	53
clay	53	63
clay	63	73
clay	73	83
clay	83	93
gravel	93	103
gravel	103	113
gravel	113	123
gravel	123	133


CODED

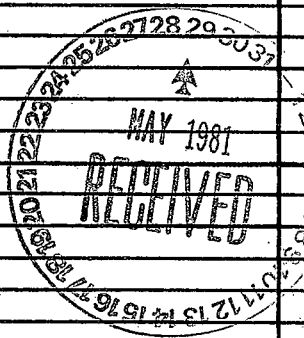

DRILLERS REMARKS:

If well telescopes please sketch and show depths.

GROUND LEVEL

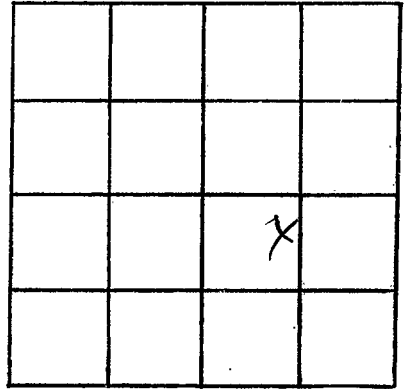

SECTION 305

Please indicate well location X.

ADDITIONAL INFORMATION

If more than one screen, show locations of each on sketch.