

MISSISSIPPI DEPARTMENT OF NATURAL RESOURCES

Bureau of Land and Water Resources

Southport Mall

P.O. Box 10631

Jackson, Mississippi 39209

CODED

WATER WELL-DRILLERS LOG

BUTANE GAS CO. OF GREENWOOD

POST OFFICE BOX 1135

GREENWOOD, MISS. 38930

Sunflower
U8
6-29-81

6-29 1981
date well completed

Sunflower
county well located

LANDOWNER: Mallotte Farms
Swifton
(mailing address)

description of formations encountered	from	to
<u>Clay</u>	<u>0</u>	<u>12</u>
<u>Shale</u>	<u>12</u>	<u>16</u>
<u>Shale + Per. Gravel</u>	<u>16</u>	<u>30</u>
<u>Sand</u>	<u>30</u>	<u>40</u>
<u>Shale + Per. Gravel</u>	<u>40</u>	<u>110</u>
<u>Fine Sand</u>	<u>110</u>	

WELL LOCATION:
sec. 3 T. 11 N. R. 3 E
4 miles NW of Swifton
(distance) (direction) (nearest town)

CODED

WELL PURPOSE: irrigation
(home, irrigation, municipal, industrial)

- WELL COMPLETION DATA:
- diameter (inches) 16
 - total depth (feet) 110
 - static water level (feet) 25 ^{below} _{above} top of ground.
 - casing Steel, 70
(material) (depth)
16 if telescope see back.
(size)
 - screen 40, 70
(length) (depth to top)
16", Steel
(size) (material)
 - pump 40, 700
(HP) (yield gpm)
Diesel
(type power)
 - electric log (yes or no) _____
(organization running log) _____
 - how well bottom plugged Steel Plate

DEPT. OF NATURAL RESOURCES
BUREAU OF LAND & WATER RESOURCES


JUL - 2 1981

RECEIVED

DRILLERS REMARKS: _____

If well telescopes please sketch and show depths.

GROUND LEVEL

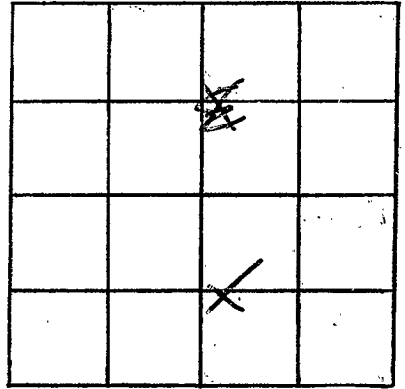

SECTION 3

Please indicate well location X.

ADDITIONAL INFORMATION

If more than one screen,
show locations of each on sketch.