

MISSISSIPPI DEPARTMENT OF NATURAL RESOURCES

Bureau of Land and Water Resources

Southport Mall

P.O. Box 10631

Jackson, Mississippi 39209


WATER WELL DRILLERS LOG

CODED

Sanflow
U 13
4-13-81


date well completed April 13 1981 firm name Lamin's Well Pump county well located Sanflow

LANDOWNER: <u>Floyd Anderson</u>	description of formations encountered	from	to
<u>Inverness MS</u> (mailing address)	<u>CLAY</u>	<u>0</u>	<u>30</u>
WELL LOCATION: sec. <u>4</u> T. <u>17</u> N R. <u>3</u> W	<u>FINE SAND CLAY</u>	<u>30</u>	<u>50</u>
<u>6</u> miles <u>E</u> of <u>Stullman</u> (distance) (direction) (nearest town)	<u>MED SAND</u>	<u>50</u>	<u>70</u>
WELL PURPOSE: (home, irrigation, municipal, industrial)	<u>COURSE SAND</u>	<u>70</u>	<u>105</u>
WELL COMPLETION DATA:	CODED		
(1) diameter (inches) <u>12"</u>			
(2) total depth (feet) <u>105'</u>			
(3) static water level (feet) <u>20</u> below above top of ground.			
(4) casing <u>Steel</u> , <u>65'</u> (material) (depth)			
(size) if telescope see back.			
(5) screen <u>40'</u> , <u>65'</u> (length) (depth to top)			
(size) <u>12"</u> , <u>Steel</u> (material)			
(6) pump <u>60</u> , <u>3000</u> (HP) (yield gpm)			
(type power)			
(7) electric log <u>NO</u> (yes or no)			
(organization running log)			
(8) how well bottom plugged <u>Steel Plate</u>			
DRILLERS REMARKS:			

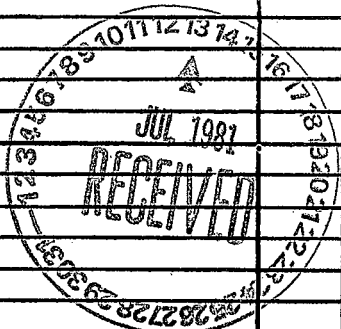

If well telescopes please sketch and show depths.

GROUND LEVEL

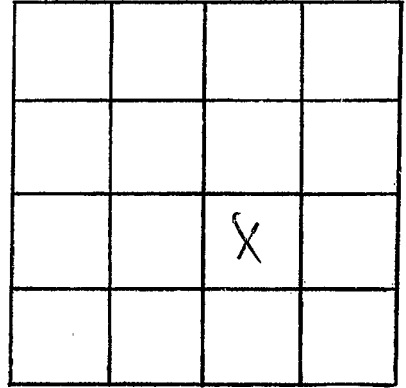

SECTION 4

Please indicate well location X.

ADDITIONAL INFORMATION

If more than one screen, show locations of each on sketch.