

MISSISSIPPI DEPARTMENT OF NATURAL RESOURCES

Bureau of Land and Water Resources

Southport Mall

P.O. Box 10631

Jackson, Mississippi 39209

WATER WELL DRILLERS LOG

CODED

SUNFLOWER
U 14
7-17-81

7/17/81 19 Deperwell - Dry Sunflower
date well completed firm name county well located

LANDOWNER: R. D. Mallette

P.O. Box 578

Oshtobla, MS.

(mailing address)

WELL LOCATION:

sec. 10 T. 17 N. R. 3 E. W
6 miles SE of Orreuss
(distance) (direction) (nearest town)

WELL PURPOSE:

(home, irrigation, municipal, industrial)

WELL COMPLETION DATA:

- (1) diameter (inches) 16
- (2) total depth (feet) 115'
- (3) static water level (feet) 21 below above top of ground.
- (4) casing Steel 75'
(material) (depth)
16 if telescope see back.
(size)
- (5) screen 40 75'
(length) (depth to top)
16 Steel
(size) (material)
- (6) pump 160 3000
(HP) (yield gpm)
Diesel
(type power)
- (7) electric log NO
(yes or no)


(organization running log)

(8) how well bottom plugged Plate

DRILLERS REMARKS:

description of formations encountered	from	to
<u>Clay</u>	<u>0</u>	<u>38</u>
<u>Sand & Gravel</u>	<u>38</u>	<u>58</u>
<u>Sand</u>	<u>58</u>	<u>68</u>
<u>Sand & Gravel</u>	<u>68</u>	<u>115</u>

CODED

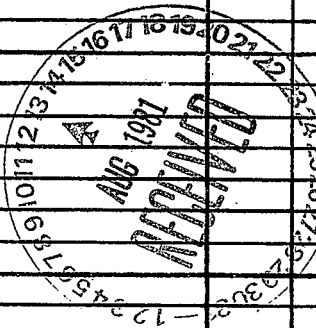

If well telescopes please sketch and show depths.

GROUND LEVEL

	X		

SECTION 10

Please indicate well location X.

ADDITIONAL INFORMATION

If more than one screen,
show locations of each on sketch.