

MISSISSIPPI DEPARTMENT OF NATURAL RESOURCES

Bureau of Land and Water Resources

Southport Mall

P.O. Box 10631

Jackson, Mississippi 39209

WATER WELL DRILLERS LOG

CODED

SUNFLOWER
U 15
8-1-81

8/1 19 Wells + Surg Sunflower
 date well completed firm name county well located

LANDOWNER: Belliamon

description of formations encountered	from	to
<u>Clay</u>	<u>13</u>	<u>23</u>
<u>Clay</u>	<u>23</u>	<u>33</u>
<u>Clay</u>	<u>33</u>	<u>43</u>
<u>Clay</u>	<u>43</u>	<u>53</u>
<u>SM</u>	<u>53</u>	<u>63</u>
<u>sandstone</u>	<u>63</u>	<u>73</u>
<u>gravel</u>	<u>73</u>	<u>83</u>
<u>gravel</u>	<u>83</u>	<u>93</u>
<u>sandstone</u>	<u>93</u>	<u>103</u>
<u>sandstone</u>	<u>103</u>	<u>113</u>

Onwersness
 (mailing address)

WELL LOCATION:
 sec. 6 T 17 N R 3 E
4 miles NE of Onwersness
 (distance) (direction) (nearest town)

WELL PURPOSE:
 (home, irrigation, municipal, industrial)

WELL COMPLETION DATA:


- (1) diameter (inches) 16
- (2) total depth (feet) 113
- (3) static water level (feet) 22 below above top of ground.
- (4) casing Steel, 73' (material) (depth)
16 if telescope see back. (size)
- (5) screen 40, 73' (length) (depth to top)
16 (size) steel (material)
- (6) pump 60, 3000 (HP) (yield gpm)
Electric (type power)
- (7) electric log No (yes or no)

(organization running log)

(8) how well bottom plugged Plate

DRILLERS REMARKS:

CODED

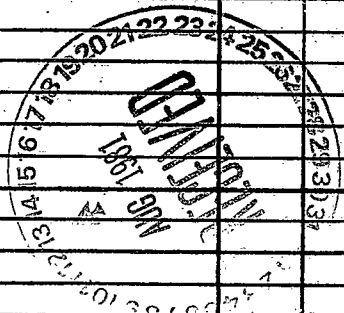

If well telescopes please sketch and show depths.

GROUND LEVEL

			X

SECTION 6

Please indicate well location X.

ADDITIONAL INFORMATION

If more than one screen,
show locations of each on sketch.