

MISSISSIPPI DEPARTMENT OF NATURAL RESOURCES

Bureau of Land and Water Resources

Southport Mall

P.O. Box 10631

Jackson, Mississippi 39209

WATER WELL DRILLERS LOG

CODED

Sunflowers
U 16
7/23/81

7/23/81
date well completed

Deveraux Irrig
firm name

Sunflower
county well located

LANDOWNER: R. N. Mallett

description of formations encountered

from

to

P.O. Box 578

Osceola, MS 38757

(mailing address)

Clay

0 18

Hard sand

18 30

sand

30 54

sand + gravel

54 103

WELL LOCATION:

sec. 10 T. 12 N. R. 3 E
6 miles SE of business
(distance) (direction) (nearest town)

WELL PURPOSE:


(home, irrigation, municipal, industrial)

CODED

WELL COMPLETION DATA:


- (1) diameter (inches) 12
- (2) total depth (feet) 103'
- (3) static water level (feet) 23' below above top of ground.
- (4) casing Steel, 63',
(material) (depth)
12' if telescope see back.
(size)
- (5) screen 40, 63'
(length) (depth to top)
12, Steel
(size) (material)
- (6) pump 40, 2000
(HP) (yield gpm)
Kleesel
(type power)
- (7) electric log NO
(yes or no)
(organization running log)
- (8) how well bottom plugged Delate

DRILLERS REMARKS:

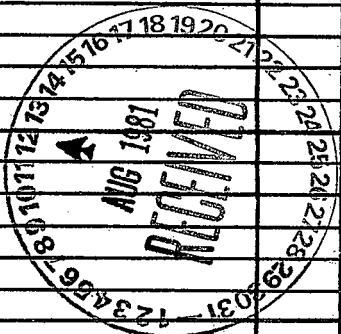

If well telescopes please sketch and show depths.

GROUND LEVEL

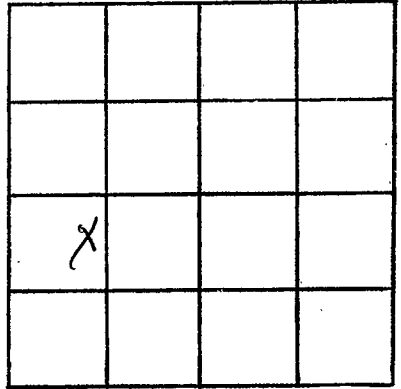

SECTION 10

Please indicate well location X.

ADDITIONAL INFORMATION

If more than one screen,
show locations of each on sketch.