

MISSISSIPPI DEPARTMENT OF NATURAL RESOURCES

Bureau of Land and Water Resources

Southport Mall

P.O. Box 10631

Jackson, Mississippi 39209

CODED

WATER WELL DRILLERS LOG

Sunflower  
U 17  
6-22-81

June 22 1981 Larry's Well & Pump Sunflower  
date well completed firm name county well located

LANDOWNER: <u>Bill King</u>	description of formations encountered	from	to
<u>Shiveness rd</u> (mailing address)	<u>CLAY</u> <u>FINE SAND</u> <u>COURSE SAND</u>	<u>0</u> <u>40</u> <u>60</u>	<u>40</u> <u>60</u> <u>103</u>
<p>WELL LOCATION:</p> <p>sec. <u>1</u> T. <u>17</u> N. R. <u>3</u> W.</p> <p><u>8</u> miles <u>SE</u> of <u>Woodland</u> (distance) (direction) (nearest town)</p>			
<p>WELL PURPOSE: (home, irrigation, municipal, industrial)</p>			
<p>WELL COMPLETION DATA:</p> <p>(1) diameter (inches) <u>16"</u></p> <p>(2) total depth (feet) <u>103'</u></p> <p>(3) static water level (feet) <u>19</u> below above top of ground.</p> <p>(4) casing <u>Steel</u>, <u>63'</u> (material) (depth) (size) if telescope see back.</p> <p>(5) screen <u>40'</u>, <u>63'</u> (length) (depth to top) <u>16"</u>, <u>Steel</u> (size) (material)</p> <p>(6) pump <u>100</u>, <u>3000</u> (HP) (yield gpm) (type power)</p> <p>(7) electric log <u>No</u> (yes or no) (organization running log)</p> <p>(8) how well bottom plugged <u>Steel Plate</u></p>			
<p>DRILLERS REMARKS:</p>			

CODED


DEPT. OF NATURAL RESOURCES  
BUREAU OF LAND & WATER RESOURCES

OCT 19 1981

RECEIVED

If well telescopes please sketch and show depths.

GROUND LEVEL

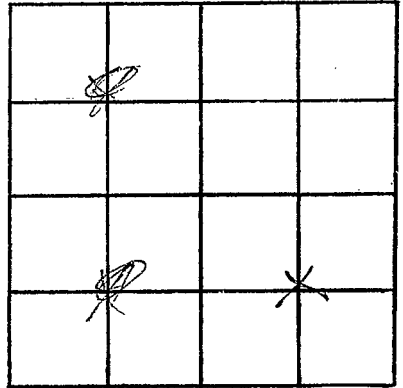

SECTION   1  

Please indicate well location X.

ADDITIONAL INFORMATION

If more than one screen,  
show locations of each on sketch.