

MISSISSIPPI DEPARTMENT OF NATURAL RESOURCES

Bureau of Land and Water Resources

Southport Mall

P.O. Box 10631

Jackson, Mississippi 39209

WATER WELL DRILLERS LOG

CODED

Sunflower
7/18
6-23-81

June 23 1981 date well completed
 Larry's Well & Pump firm name
 Sunflower county well located

LANDOWNER: Bill Langford
Lawrence Mo
 (mailing address)

description of formations encountered	from	to
CLAY	0	40
FINE SAND	40	60
COARSE SAND	60	102

WELL LOCATION:
 sec. 1 T. 17 N. R. 3 E
8 miles SE of Marshall
 (distance) (direction) (nearest town)

WELL PURPOSE:
 (home, irrigation, municipal, industrial)

WELL COMPLETION DATA:

(1) diameter (inches) 16"

(2) total depth (feet) 102'

(3) static water level (feet) 20 below top of ground.

(4) casing Steel, 62'
 (material) (depth)
 (size) if telescope see back.

(5) screen 40', 62'
 (length) (depth to top)
16", Steel
 (size) (material)

(6) pump 60, 3000
 (HP) (yield gpm)
 (type power)

(7) electric log No
 (yes or no)
 (organization running log)

(8) how well bottom plugged Steel Plate

CODED

DEPT. OF NATURAL RESOURCES
 BUREAU OF LAND & WATER RESOURCES


OCT 19 1981

RECEIVED

DRILLERS REMARKS:

If well telescopes please sketch and show depths.

GROUND LEVEL

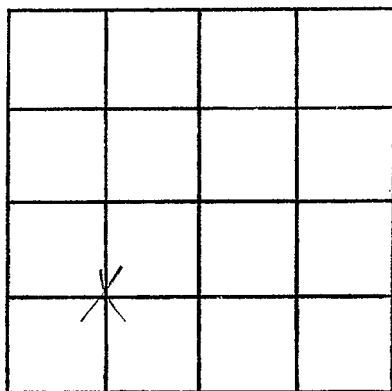

SECTION /

Please indicate well location X.

ADDITIONAL INFORMATION

If more than one screen, show locations of each on sketch.