

MISSISSIPPI DEPARTMENT OF NATURAL RESOURCES

Bureau of Land and Water Resources

Southport Mall

P.O. Box 10631

Jackson, Mississippi 39209

CODED

WATER WELL DRILLERS LOG

Sunflower  
U 19  
6-23-81

June 23 19 81 Rams well & Pump Sunflower  
 date well completed firm name county well located

LANDOWNER: Bill Lang  
Lawrence, mo  
 (mailing address)

description of formations encountered	from	to
CLAY	0	40
FINE SAND	40	60
COPSE SAND	60	164

WELL LOCATION:  
 sec. 1 T 17 N R. 3 W  
8 miles SE of Marshall  
 (distance) (direction) (nearest town)

WELL PURPOSE:  
 (home, irrigation, municipal, industrial)

WELL COMPLETION DATA:

(1) diameter (inches) 16"

(2) total depth (feet) 104'

(3) static water level (feet) 20 below top of ground.

(4) casing Steel, 64'  
 (material) (depth)  
 (size) if telescope see back.

(5) screen 40', 64'  
 (length) (depth to top)  
16", Steel  
 (size) (material)

(6) pump 60 3000  
 (HP) (yield gpm)  
 (type power)

(7) electric log NO  
 (yes or no)  
 (organization running log)

(8) how well bottom plugged Steel Plate

CODED

DEPT. OF NATURAL RESOURCES  
 BUREAU OF LAND & WATER RESOURCES


OCT 19 1981

RECEIVED

DRILLERS REMARKS:

If well telescopes please sketch and show depths.

GROUND LEVEL

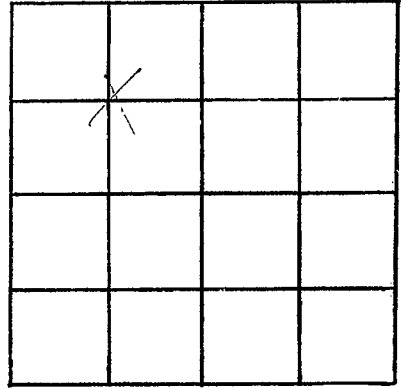

SECTION

Please indicate well location X.

ADDITIONAL INFORMATION

If more than one screen, show locations of each on sketch.