

MISSISSIPPI DEPARTMENT OF NATURAL RESOURCES

Bureau of Land and Water Resources

Southport Mall

P.O. Box 10631

Jackson, Mississippi 39209

CODED

WATER WELL DRILLERS LOG


<i>Sentawen</i>
<i>U 20</i>
<i>2/27/82</i>
<i>Feb 23 1982</i>

date well completed Feb 23 1982 firm name Leamy's well & pump county well located Sentawen

LANDOWNER: <u>J.L. Beckam</u>	description of formations encountered	from	to
Inverness MS. (mailing address)	<i>slay</i>	<i>0</i>	<i>20</i>
WELL LOCATION: sec. <u>6</u> 17 N S R <u>3</u> E W <u>2</u> miles <u>East</u> of <u>Inverness</u> (distance) (direction) (nearest town)	<i>med fine sand</i>	<i>20</i>	<i>60</i>
WELL PURPOSE: (home, irrigation, municipal, industrial)	<i>med & coarse sand</i>	<i>60</i>	<i>122</i>
WELL COMPLETION DATA:			
(1) diameter (inches) <u>12"</u>			
(2) total depth (feet) <u>122'</u>			
(3) static water level (feet) <u>24'</u> <u>below</u> <u>above</u> top of ground.			
(4) casing <u>Steel</u> , <u>82'</u> (material) (depth)			
<u> </u> if telescope see back. (size)			
(5) screen <u>40'</u> , <u>82'</u> (length) (depth to top)			
<u>12"</u> , <u>Steel</u> (size) (material)			
(6) pump <u>40</u> , <u>2000</u> (HP) (yield gpm)			
<u>D</u> (type power)			
(7) electric log <u>NO</u> (yes or no)			
<u> </u> (organization running log)			
(8) how well bottom plugged <u>Steel Plate</u>			
DRILLERS REMARKS:	<p>DEPT. OF NATURAL RESOURCES BUREAU OF LAND & WATER RESOURCES</p> <p>JUN 21 1982</p> <p>RECEIVED</p>		

If well telescopes please sketch and show depths.

GROUND LEVEL

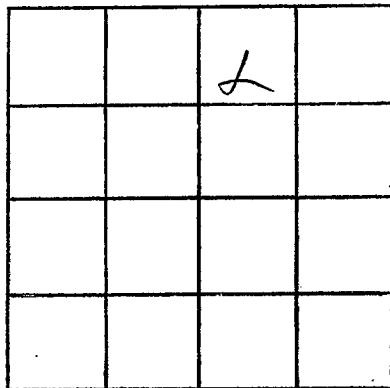

SECTION ~~1~~ 2

Please indicate well location X.

ADDITIONAL INFORMATION

If more than one screen,
show locations of each on sketch.