

MISSISSIPPI DEPARTMENT OF NATURAL RESOURCES

Bureau of Land and Water Resources

Southport Mall

P.O. Box 10631

Jackson, Mississippi 39209

WATER WELL DRILLERS LOG

CODED

SUNFLOWER  
421

3-27-84

date well completed

19 Irrigation Equipment

firm name

Sumner

county well located

| LANDOWNER: <u>W.D. Simmons</u>  | description of formations encountered | from      | to         |
|---|---------------------------------------|-----------|------------|
| <u>P.O. Bonds</u>   |                                       |           |            |
| <u>Baird, Mo. 38724</u><br>(mailing address)  | <u>clay</u>                           | <u>0</u>  | <u>15</u>  |
|   | <u>sand</u>                           | <u>16</u> | <u>55</u>  |
|   | <u>sand + gravel</u>                  | <u>56</u> | <u>103</u> |
| <p>WELL LOCATION:</p> <p>sec. <u>6</u> T. <u>17</u> N. R. <u>3</u> E. S. <u>1</u></p> <p><u>4 1/4</u> miles <u>W</u> of <u>INDEPENDENCE</u><br/>(distance) (direction) (nearest town)</p> |                                       |           |            |
| <p>WELL PURPOSE: <u>Irrigation</u><br/>(home, irrigation, municipal, industrial)</p>  |                                       |           |            |
| <p>WELL COMPLETION DATA:</p>  |                                       |           |            |
| <p>(1) diameter (inches) <u>12"</u></p>   |                                       |           |            |
| <p>(2) total depth (feet) <u>103'</u></p>   |                                       |           |            |
| <p>(3) static water level (feet) <u>20'</u> below above top of ground.</p>  |                                       |           |            |
| <p>(4) casing <u>steel</u> <u>63'</u><br/>(material) (depth)</p>  |                                       |           |            |
| <p>(size) If telescope see back.</p>  |                                       |           |            |
| <p>(5) screen <u>40'</u> <u>63'</u><br/>(length) (depth to top)</p>   |                                       |           |            |
| <p><u>12"</u> <u>steel</u><br/>(size) (material)</p>  |                                       |           |            |
| <p>(6) pump _____ (HP) _____ (yield gpm)</p>  |                                       |           |            |
| <p>(type power)</p>   |                                       |           |            |
| <p>(7) electric log _____ (yes or no)</p>   |                                       |           |            |
| <p>(organization running log)</p>   |                                       |           |            |
| <p>(8) how well bottom plugged <u>steel plate</u></p>   |                                       |           |            |
| <p>DRILLERS REMARKS:</p>  |                                       |           |            |

CODED


DEPT. OF NATURAL RESOURCES  
BUREAU OF LAND & WATER RESOURCES

SEP - 4 1984

RECEIVED

If well telescopes please  
sketch and show depths.

GROUND LEVEL

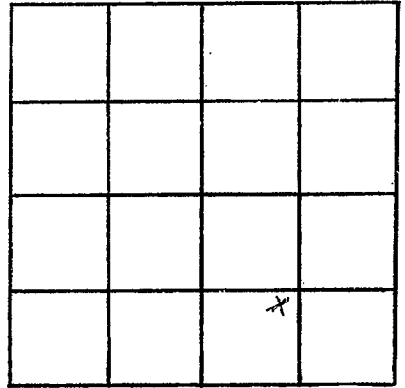

SECTION 6

Please indicate well location X.

ADDITIONAL INFORMATION

If more than one screen,  
show locations of each on sketch.