

MISSISSIPPI DEPARTMENT OF NATURAL RESOURCES

Bureau of Land and Water Resources

Southport Mall

P.O. Box 10631

Jackson, Mississippi 39209

WATER WELL DRILLERS LOG

CODED

SUNFLOWER  
U 22

3-27-84  
date well completed

Irrigation equipment  
firm name

Sunflower  
county well located

LANDOWNER: W.D. Simmons  
P.O. Box 45  
Boind, Ms. 38724  
(mailing address)

description of formations encountered	depth	
	from	to
Clay	0	15
Sand	16	63
Sand + gravel	64	105

WELL LOCATION:  
sec. 6 T. 17 N. R. 3 E  
S. 4 miles W of INVERNESS  
(distance) (direction) (nearest town)

WELL PURPOSE: Irrigation  
(home, irrigation, municipal, industrial)

- WELL COMPLETION DATA:
- (1) diameter (inches) 12"
  - (2) total depth (feet) 105'
  - (3) static water level (feet) 21' below above top of ground.
  - (4) casing Steel 65'  
(material) (depth)
  - (size) If telescope see back.
  - (5) screen 40' 65'  
(length) (depth to top)
  - 12" Steel  
(size) (material)
  - (6) pump \_\_\_\_\_ (HP) \_\_\_\_\_ (yield gpm)
  - (type power) \_\_\_\_\_
  - (7) electric log \_\_\_\_\_ (yes or no)
  - (organization running log) \_\_\_\_\_
  - (8) how well bottom plugged Sealed


CODED

DEPT. OF NATURAL RESOURCES  
BUREAU OF LAND & WATER RESOURCES  
SEP - 4 1984  
RECEIVED

DRILLERS REMARKS:

If well telescopes please sketch and show depths.

GROUND LEVEL

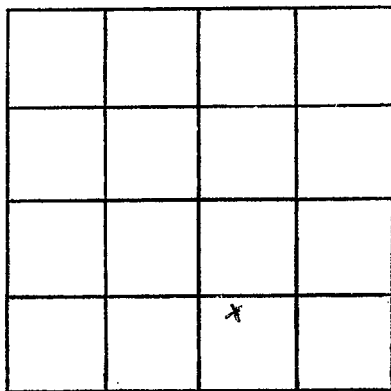

SECTION 6

Please indicate well location X.

ADDITIONAL INFORMATION

If more than one screen,  
show locations of each on sketch.