

MISSISSIPPI DEPARTMENT OF NATURAL RESOURCES

Bureau of Land and Water Resources

Southport Mall

P.O. Box 10631

Jackson, Mississippi 39209 **CODED**

**WATER WELL DRILLERS LOG**

U24  
SUNFLOWER  
7-12-84

July 12, 1984 Larry's well & pump Sunflower  
date well completed firm name county well located

LANDOWNER: Floyd Anderson

description of formations encountered	from	to
clay	0	20
First Sand	20	50
Wave Sand	50	103

Inverness Mo  
(mailing address)

WELL LOCATION:

sec. 4 T. 17 N R. 3 E  
S S W  
5 miles East of Inverness  
(distance) (direction) (nearest town)

WELL PURPOSE:  
(home, irrigation, municipal, industrial)

WELL COMPLETION DATA:

- (1) diameter (inches) 12"
- (2) total depth (feet) 103'
- (3) static water level (feet) 26' below above top of ground.
- (4) casing steel 63' (material) (depth)  
(size) If telescope see back.
- (5) screen 40' 63' (length) (depth to top)  
12" steel (size) (material)
- (6) pump 40 1500 (HP) (yield gpm)  
D (type power)
- (7) electric log No (yes or no)

(organization running log)

(8) how well bottom plugged Steel Plate

DRILLERS REMARKS:


DEPT. OF NATURAL RESOURCES  
BUREAU OF LAND & WATER RESOURCES

NOV 29 1984

RECEIVED

If well telescopes please sketch and show depths.

GROUND LEVEL

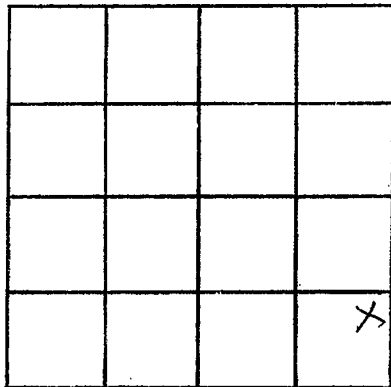

SECTION 4

Please indicate well location X.

ADDITIONAL INFORMATION

If more than one screen, show locations of each on sketch.