

MISSISSIPPI DEPARTMENT OF NATURAL RESOURCES

Bureau of Land and Water Resources

Southport Mall

P.O. Box 10631

Jackson, Mississippi 39209

WATER WELL DRILLERS LOG

CODED

SUNFLOWER  
U-26

1-16-86 date well completed 19 IRRIGATION Equipment firm name SUNFLOWER county well located

LANDOWNER: Lee P. ARRINGTON  
Rt. 1, Macon Lake Road  
INVERNESS, MS 38753  
(mailing address)

| description of formations encountered | from | to  |
|---------------------------------------|------|-----|
| clay                                  | 0    | 45  |
| fine sand                             | 45   | 55  |
| coarse sand                           | 55   | 75  |
| coarse sand/pea gravel                | 75   | 115 |

WELL LOCATION:  
sec. 4 T. 17 N R. 3 E  
S W  
5 miles EAST of INVERNESS  
(distance) (direction) (nearest town)

WELL PURPOSE: PUDT  
(home, irrigation, municipal, industrial)

- WELL COMPLETION DATA:
- (1) diameter (inches) 16"
  - (2) total depth (feet) 115
  - (3) static water level (feet) 20 below above top of ground.
  - (4) casing STEEL 75'  
(material) (depth)
  - (size) if telescope see back.
  - (5) screen 40' 75'  
(length) (depth to top)
  - 16" STEEL  
(size) (material)
  - (6) pump 60 1200  
(HP) (yield gpm)
  - Diesel Power Unit  
(type power)
  - (7) electric log NO  
(yes or no)

RECEIVED

JAN 23 1986

Department of Natural Resources,  
Bureau of Land & Water Resources


(organization running log) STEEL  
(8) how well bottom plugged PLATE

DRILLERS REMARKS:

If well telescopes please sketch and show depths.

IRRIGATION EQUIPMENT  
601/887-2555  
INDIANOLA, MS

GROUND LEVEL

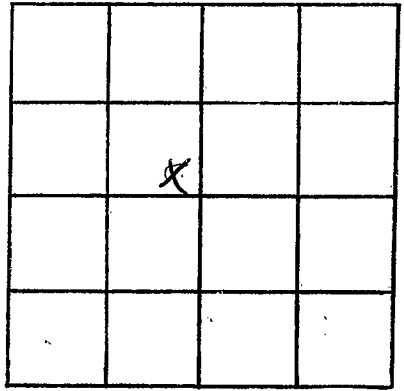

SECTION 4

Please indicate well location X.

ADDITIONAL INFORMATION

If more than one screen, show locations of each on sketch.