

MISSISSIPPI DEPARTMENT OF NATURAL RESOURCES P

Bureau of Land and Water Resources

Southport Mall

P.O. Box 10631

Jackson, Mississippi 39209

WATER WELL DRILLERS LOG

CODEN

Sunflower
U 29

May 14 19 85 date well completed
Lannis well pump firm name
Sunflower county well located

LANDOWNER: Mrs. K. Polk Vanzandt

description of formations encountered

from to

Inverness, MS
(mailing address)

Clay 0 26
Fine Sand 26 50
Coarse Sand 50 106

WELL LOCATION:

CODEN


sec. 2 T. 17 N. R. 3 E.
S. 3 W.
3 miles E of Inverness
(distance) (direction) (nearest town)

WELL PURPOSE:

(home, irrigation, municipal, industrial)

WELL COMPLETION DATA:

- (1) diameter (inches) 16"
- (2) total depth (feet) 106'
- (3) static water level (feet) 27' below top of ground.
- (4) casing Steel 66' (material) (depth)
- (size) If telescope see back.
- (5) screen 40' 66' (length) (depth to top)
- 16" (size) Steel (material)
- (6) pump 60 1600 (HP) (yield gpm)
- DS1 (type power)
- (7) electric log No (yes or no)

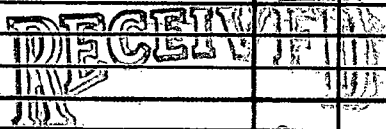

JUN 23 1986

Department of Natural Resources
Bureau of Land & Water Resources


(organization running log)

(8) how well bottom plugged Steel Plate

DRILLERS REMARKS:

If well telescopes please sketch and show depths.

GROUND LEVEL

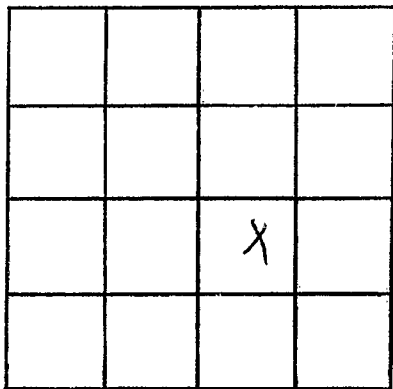

SECTION 2

Please indicate well location X.

ADDITIONAL INFORMATION

If more than one screen,
show locations of each on sketch.