

MISSISSIPPI DEPARTMENT OF NATURAL RESOURCES P

Bureau of Land and Water Resources

Southport Mall

P.O. Box 10631

Jackson, Mississippi 39209

WATER WELL DRILLERS LOG

CODED

Sumner  
U30

7-09  
date well completed

1985 Larry's Well Drilling  
firm name

Sumner  
county well located

LANDOWNER: R.L. Maxwell  
Shiveness mo.  
(mailing address)

description of formations encountered

from	to
<u>0</u>	<u>25</u>
<u>25</u>	<u>60</u>
<u>60</u>	<u>116</u>


clay  
Fine Sand  
coarse sand & gravel

WELL LOCATION:  
sec. 10 T. 17 N. R. 3 E.  
S. 3 W.  
5 miles W of Swiftown  
(distance) (direction) (nearest town)

CODED

WELL PURPOSE: Fish Pond  
(home, irrigation, municipal, industrial)

- WELL COMPLETION DATA:
- (1) diameter (inches) 16"
  - (2) total depth (feet) 116
  - (3) static water level (feet) 23' below above top of ground.
  - (4) casing steel, 76'  
(material) (depth)  
(size) If telescope see back.
  - (5) screen 40', 76'  
(length) (depth to top)  
16", steel  
(size) (material)
  - (6) pump 60, 3000  
(HP) (yield gpm)  
DSI  
(type power)
  - (7) electric log NO  
(yes or no)  
(organization running log)
  - (8) how well bottom plugged Steel plate

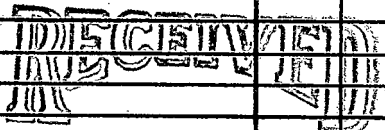


JUN 23 1986

Department of Natural Resources  
Bureau of Land & Water Resources

DRILLERS REMARKS:

If well telescopes please sketch and show depths.

GROUND LEVEL

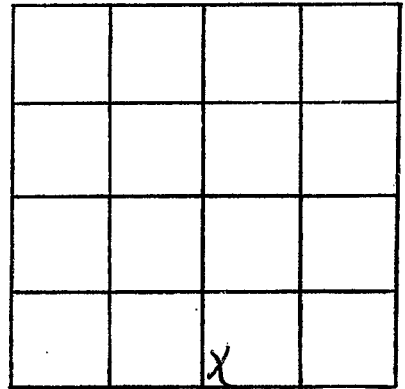

SECTION 10

Please indicate well location X.

ADDITIONAL INFORMATION

If more than one screen, show locations of each on sketch.