

MISSISSIPPI DEPARTMENT OF NATURAL RESOURCES

Bureau of Land and Water Resources

Southport Mall

P.O. Box 10631

Jackson, Mississippi 39209

WATER WELL DRILLERS LOG

TEP 11054  
 LAR-08-03-88  
 U 38  
 CODED

CODED

6-15 1988 Dyer Well Sunflower  
 date well completed firm name county well located

LANDOWNER R L Maxwell  
 Fish Farm

description of formations encountered

from to

Inverness Ms  
 (mailing address)

Clay	0	24
M. Sand & Gravel	24	42
Line Sand	42	69
Sand & Gravel	69	88
M Sand & Gravel	88	104
Sand & Gravel	104	115

WELL LOCATION:

sec. 20 T 17 N R 3 E W  
 (distance) miles (direction) of (nearest town)

WELL PURPOSE: Fish Pond  
 (home, irrigation, municipal, industrial)

WELL COMPLETION DATA:

- (1) diameter (inches) 16"
- (2) total depth (feet) 115'
- (3) static water level (feet) \_\_\_\_\_ below above top of ground.
- (4) casing steel (material) (depth) \_\_\_\_\_  
 16 (size) If telescope see back.
- (5) screen 40 (length) (depth to top) \_\_\_\_\_  
 16 (size) (material)
- (6) pump 60 (HP) (yield gpm) \_\_\_\_\_  
 Gear (type power)
- (7) electric log No (yes or no)  
 None (organization running log)
- (8) how well bottom plugged Plate


RECEIVED  
 JUL 11 1988

Department of Natural Resources  
 Bureau of Land & Water Resources

DRILLERS REMARKS:

If well telescopes please sketch and show depths.

GROUND LEVEL

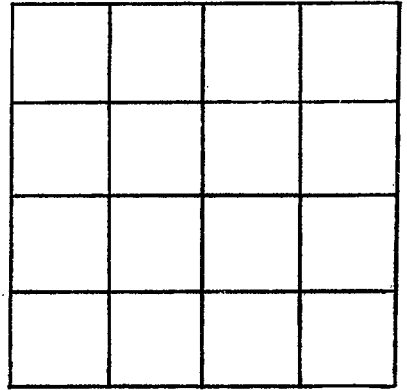

SECTION \_\_\_\_\_

Please indicate well location X.

ADDITIONAL INFORMATION

If more than one screen,  
show locations of each on sketch.