

Drilled 11-15-01

Completed 5-02

MISSISSIPPI DEPARTMENT OF ENVIRONMENTAL QUALITY

Office of Land and Water Resources

COUNTY WELL LOCATED
Sunflower

WELL NUMBER CODED
U-53

DATE WELL COMPLETED
11-15-01

PERMIT NUMBER
MSFW-39258

NAME OF DRILLING FIRM
Irrigation Equipment Inc.

Indianola, MS

P. O. Box 10631
Jackson, MS 39289-0631
WATER WELL DRILLERS LOG

NAME & MAILING ADDRESS OF LANDOWNER
Anderson Planting

550 Three Mile Lake Rd.
Inverness, MS 38753

Latitude:
Longitude:

WELL LOCATION SEC TOWNSHIP RANGE
NW/NW 5 17N S 3W E

DISTANCE DIRECTION NEAREST TOWN
Miles East of Inverness

OTHER LANDMARK

WELL PURPOSE: Home, Irrigation, Municipal, Industrial, Fish Pond, etc.
Irrigation

PUMP DATA

PUMP TYPE (Circle One):
Submersible, Turbine, Jet, Flowing Well,
Other (Describe)

POWER TYPE (Circle One):
Electric, Tractor, Diesel, Gasoline, Butane,
Other (Describe) **HP 60**

DESCRIPTION OF FORMATIONS ENCOUNTERED	FROM	TO
Clay	0	18
Fine Sand	18	55
Fine Sand/Gravel	55	68
Med. Sand/Gravel	68	107
Clay	107	110

WELL GROUDED TO A DEPTH OF FEET
Type Grout (circle one): Cement, Bentonite, or Mix

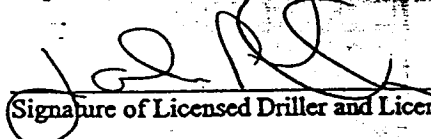
SCREEN DATA

Diameter - Inches	Length - Feet	Slot Size - Inches
16	40	050

Screen Type: **pvc** Depth to Bottom - Feet: **110**

Top of Lap Pipe or Reduction in Casing
FEET IF TELESCOPED OR MORE THAN ONE SCREEN: USE BACK PAGE

I certify that the well was drilled, constructed and completed in accordance with all applicable Requirements of the Mississippi Department of Environmental Quality and/or the Mississippi Department of Health regulations and state laws.

 0439
Signature of Licensed Driller and License No.

6-10-02

Date

Additional Information Required On Back

*From YMD folder
GW-39258*

DO NOT REMOVE ORIGINALS