

MISSISSIPPI DEPARTMENT OF NATURAL RESOURCES

Bureau of Land and Water Resources

COUNTY WELL LOCATED
Sunflower

WELL NUMBER
U

CODED
2000

DATE WELL COMPLETED
3-28-89

PERMIT NUMBER
147D or 148C

NAME OF DRILLING EQUIPMENT
601/887-2555

INDIANOLA, MS

P.O. Box 10631
Jackson, Mississippi 39209
WATER WELL DRILLERS LOG

NAME & MAILING ADDRESS OF LANDOWNER
FLOYD ANDERSON
Rt. 1, BOX 52
INVERNESS, MS 38753

WELL LOCATION: SEC **4** TOWNSHIP **17^N** RANGE **3^E**

DISTANCE **6** Miles DIRECTION **South** of NEAREST TOWN **MODRHEAD**

OTHER LANDMARK

WELL PURPOSE: Home, Irrigation, Municipal, Industrial, Fish Pond, etc.
IRRIGATION

PUMP DATA

PUMP TYPE (Circle One):
 Submersible, Turbine, Jet, Flowing Well,
Other (Describe)

POWER TYPE (Circle One):
 Electric, Tractor, Diesel, Gasoline, Butane,
Other (Describe) H/P **10**

Pump Capacity (GPM) **550** No. of Stages **1** Setting Depth **60** FT.

PUMP TEST

Well yielded _____ GPM with
a drawdown of _____ ft.
after _____ hours of pumping

WELL DATA

Well Depth **115'** Casing Diameter (In.) **8** Casing Length (Ft.) **75**

Type of Casing **PVC** Hole Depth **115'** Depth to Static Water Level **25'**

TYPE OF COMPLETION: (Circle One or More):
 Gravel Packed, Underreamed, Telescoped,
Natural Development, Open Hole, Other

Top of Lap Pipe or Reduction in Casing

FEET IF TELESCOPED OR MORE THAN ONE SCREEN: USE BACK PAGE

LOG DATA

TYPE OF LOG RUN (Circle One): No Log Run,
Electric, Gamma Ray, Density, Sonic, Neutron,
Other (Describe)

Name of Organization Running Log

SCREEN DATA

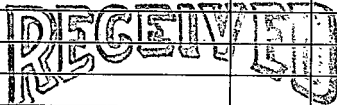
Diameter - Inches **8** Length - Feet **40** Slot Size - Inches **.050**

Screen Type **PVC** Depth to Bottom - Feet **40**

GEOLOGIC DATA (Office Use Only)

Surface Elev.	Geologic Unit	Unit Thickness	Depth to Top
Subs. SWL	Date	Analysis	Aquifer Test

Driller's Remarks

DESCRIPTION OF FORMATIONS ENCOUNTERED	FROM	TO	FORMATIONS (Continued)	FROM	TO
clay	0	27	 APR 05 1989 Department of Natural Resources Bureau of Land & Water Resources		
Fine SAND	27	75			
medium SAND	75	100			
COARSE SAND + GRAVEL	100	115			

IF MORE SPACE IS NEEDED, USE BACK

If well telescopes please sketch and show depths.

IRRIGATION EQUIPMENT.
601/887-2555
INDIANOLA, MS

GROUND LEVEL

			X

SECTION 4

Please indicate well location X.

ADDITIONAL INFORMATION

If more than one screen,
show location of each on sketch.