

A 10
3-6-64

WATER WELL DRILLERS LOG

Tallahatchie

Date: Mar 6, 1964, Driller: Frank Light County Danesh
(Name)

(1) Owner of Land: K.C. Petrus
(Name)
Charleston
(Address)

(2) Location: 1/4, 1/4, Sec 27 T26R2E
6 miles do. of Charleston
(distance) (direction) (Nearest Town)

(3) Topography: Hilly
(Hilly) (Flat) (Level)

(4) Purpose of Well: Domestic
(Domestic Irrigation
Municipal, Industrial, Other)

Description & Color of Materials Sand, Clay, Red Clay, Shell, etc.	Thick- ness Feet	Depth Feet
<u>Clay</u>	<u>0</u>	<u>20</u>
<u>fine sand</u>	<u>20</u>	<u>81</u>
<u>sand</u>	<u>81</u>	<u>115</u>
<u>up sand</u>	<u>115</u>	<u>124</u>

Information upon completion of well:

(1) Diameter 2 inches.

(2) Total Depth 124 feet.

(3) Water Level 50 feet below top of ground.

(4) Cased to 109, Size 2


(5) Screen: Size 1/4, Length 6'

(6) Were any formations sealed against pollution?
_____ yes, _____ no.

If YES depth of formation _____

Why _____

Drillers Remarks: _____

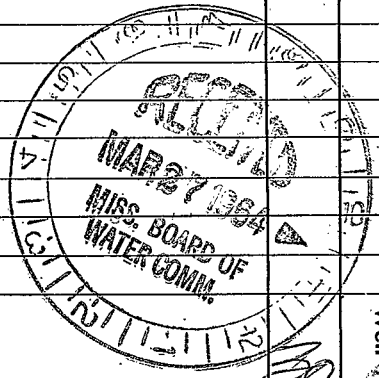

(Use Back Side)

