

Tallahatchie
A 14
5-6-70

MISSISSIPPI
 BOARD OF WATER COMMISSIONERS
 416 North State Street
 Jackson, Mississippi 39201

WATER WELL DRILLERS LOG

May 6 1970 HPE WELL CO. TALLAHATCHIE
 date well completed firm name county well located

LANDOWNER:
Ray Bonner
Teasdale, Miss
 (mailing address)

WELL LOCATION: 001
 sec. 17 T. 26N R. 2 W.
3 miles NW of Teasdale
 (distance) (direction) (nearest town)

WELL PURPOSE: home
 (home, irrigation, municipal, industrial)

- WELL COMPLETION DATA:
- (1) diameter (inches) 4"
 - (2) total depth (feet) 220
 - (3) static water level (feet) 120 below above top of ground.
 - (4) casing PVC 212
 (material) (depth)
4" If telescope see back.
 (size)
 - (5) screen 8' 212
 (length) (depth to top)
4" pre + silica
 (size) (material)
 - (6) pump 3/4 10
 (HP) (yield gpm)
elec
 (type power)
 - (7) electric log no
 (yes or no)
✓
 (organization running log)
 - (8) how well bottom plugged PVC
cap

description of formations encountered	from	to
<u>clay</u>	<u>0</u>	<u>20</u>
<u>clay</u>	<u>20</u>	<u>40</u>
<u>clay + sand</u>	<u>40</u>	<u>60</u>
" "	<u>60</u>	<u>80</u>
" "	<u>80</u>	<u>100</u>
" "	<u>100</u>	<u>120</u>
<u>sand</u>	<u>120</u>	<u>140</u>
<u>sand</u>	<u>140</u>	<u>160</u>
<u>sand</u>	<u>160</u>	<u>180</u>
<u>sand</u>	<u>180</u>	<u>200</u>
<u>sand</u>	<u>200</u>	<u>220</u>


MAY 18 1970

MISS. BD. OF
 WATER COMMISSIONERS

DRILLERS REMARKS:

If well telescopes please sketch and show depths.

GROUND LEVEL

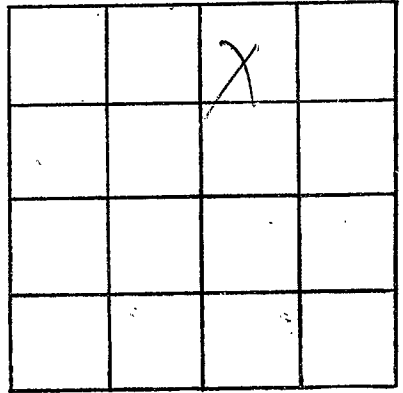

SECTION 12

Please indicate well location X.

ADDITIONAL INFORMATION

If more than one screen,
show locations of each on sketch.