

TALLA.

WATER WELL DRILLERS LOG

**CODED**

Date: 5/29, 1962, Driller: Joe. R. Lipe County: Franklin  
5-29-62 (Name)

(1) Owner of Land: Jahn S. Dahl  
(Name)  
Enid, Miss  
(Address)  
(2) Location: 1/4, 1/4, Sec. 11 T. 26 R. 2 E  
miles \_\_\_\_\_, of \_\_\_\_\_  
(distance) (direction) (Nearest Town)  
(3) Topography: Hilly  
(Hilly) (Flat) (Level)  
(4) Purpose of Well: Domestic  
(Domestic Irrigation  
Municipal, Industrial, Other)

Description & Color of Materials Sand, Clay, Red Clay, Shell, etc.	Thick- ness Feet	Depth Feet
<u>top soil &amp; clay</u>	<u>0</u>	<u>5</u>
<u>clay</u>	<u>5</u>	<u>10</u>
<u>gravel</u>	<u>15</u>	<u>10</u>
<u>gravel &amp; sand</u>	<u>40</u>	<u>60</u>
<u>sand</u>	<u>60</u>	<u>75</u>
<u>up-leaving sand</u>	<u>75</u>	<u>91</u>


Information upon completion of well:

(1) Diameter 2 inches.  
(2) Total Depth 91' feet.  
(3) Water Level 75' feet below top of ground.  
(4) Cased to 82', Size 2"  
(5) Screen: Size 1/4", Length 6'  
(6) Were any formations sealed against pollution?  
\_\_\_\_\_ yes,  no.

If YES depth of formation \_\_\_\_\_  
Why \_\_\_\_\_

Drillers Remarks: \_\_\_\_\_  
\_\_\_\_\_  
\_\_\_\_\_

**CODED**

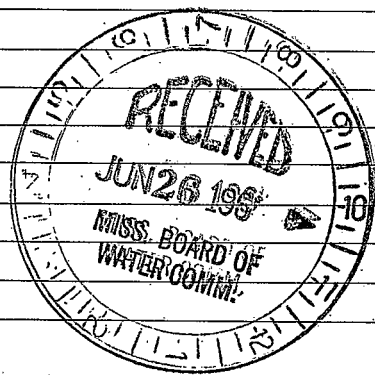

(Use Back Side)

Retain this copy for your office files.

Well No.

