

TALLAHATCHIE

Quitman  
A 20  
2-27-74

MISSISSIPPI  
BOARD OF WATER COMMISSIONERS  
416 North State Street  
Jackson, Mississippi 39201

CODED

WATER WELL DRILLERS LOG TALLAHATCHIE

Feb 27 1974 AB Can Quitman  
date well completed (Big Stream) firm name county well located

LANDOWNER: Mr. CASTLEBERG

description of formations encountered from to

(mailing address)

WELL LOCATION:  
sec. 18 T. 26 N. R. 2 E  
S W  
2 miles S of Chowder  
(distance) (direction) (nearest town)

Clay sand 0 30  
Sand 30 80  
gravel 80 120  
Clay & Rock Str. 120 500  
Sand 500 530

WELL PURPOSE:  
(home, irrigation, municipal, industrial)

WELL COMPLETION DATA:

- (1) diameter (inches) 2"
- (2) total depth (feet) 530
- (3) static water level (feet) flow below above top of ground.
- (4) casing PLASTIC 530,  
(material) (depth)  
if telescope see back.  
(size)
- (5) screen 30', 500  
(length) (depth to top)  
2", PLASTIC  
(size) (material)
- (6) pump 18  
(HP) (yield gpm)  
type power
- (7) electric log no  
(yes or no)

CODED

(organization running log)

(8) how well bottom plugged Plug


DRILLERS REMARKS:

MAR 20 1974

MISS. Bd. OF WATER COMM.

If well telescopes please sketch and show depths.

GROUND LEVEL

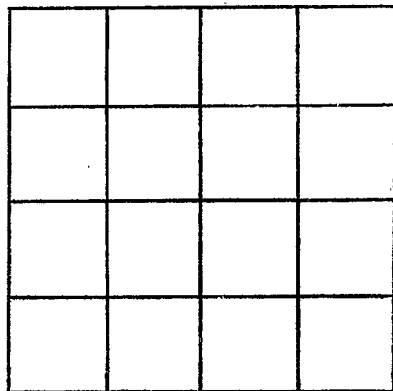

SECTION \_\_\_\_\_

Please indicate well location X.

ADDITIONAL INFORMATION

If more than one screen, show locations of each on sketch.