

Tallahatchie
 A 22
 7-68
 GW06564

MISSISSIPPI
 BOARD OF WATER COMMISSIONERS
 416 North State Street
 Jackson, Mississippi 39201
 WATER WELL DRILLERS LOG

8/21/68
 No 2720
 CODED

July 18th 1968 Layne-Central Company Tallahatchie
 date well completed firm name county well located

LANDOWNER: John Sherman
 Charleston, Mississippi
 (mailing address)
 WELL LOCATION:
 sec. 21 T 26 N R 2 E
 S W
 7 miles north of Charleston
 (distance) (direction) (nearest town)


description of formations encountered	from	to
Clay	0	25
Coarse white sand	25	31
Clay	31	38
Coarse sand	38	60
Coarse sand, pea gravel and gravel	60	102

WELL PURPOSE: irrigation
 (home, irrigation, municipal, industrial)

WELL COMPLETION DATA:

- (1) diameter (inches) 10
- (2) total depth (feet) 102
- (3) static water level (feet) 23' ~~xxxx~~ above top of ground.
- (4) casing steel (material), (depth)
 10" (size) If telescope see back.
- (5) screen 30' (length), 102' (depth to top)
 10" (size), Armco (material)
- (6) pump 30 (HP), 1000 (yield gpm)
 engine (type power)
- (7) electric log no (yes or no)
 (organization running log)
- (8) how well bottom plugged plate

CODED

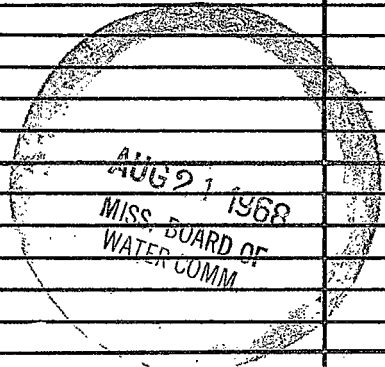


DRILLERS REMARKS:

If well telescopes please sketch and show depths.

*well on North and South
Half Section line dividing
the SE 1/4 and SW 1/4*

GROUND LEVEL

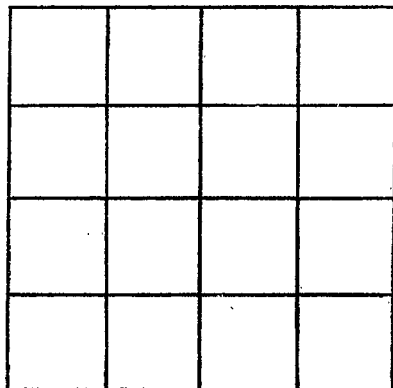

SECTION _____

Please indicate well location X.

ADDITIONAL INFORMATION

If more than one screen,
show locations of each on sketch.