

J. B. Cain

MISSISSIPPI  
BOARD OF WATER COMMISSIONERS  
416 North State Street  
Jackson, Mississippi 39201

CODED

Jalleshatchie  
A 23  
9-68

WATER WELL DRILLERS LOG

date well completed 19 9-10-68 firm name Jalleshatchie county well located

LANDOWNER Mr Wallace  
Churidge  
Charleston  
(mailing address)

description of formations encountered	from	to
<u>5' no cl</u>	<u>0</u>	<u>50</u>
<u>sand &amp; sh</u>	<u>50</u>	<u>120</u>
<u>blue sh</u>	<u>120</u>	<u>170</u>
<u>sand</u>	<u>170</u>	<u>190</u>

WELL LOCATION:  
sec 34 T 26 N R 2 E  
5 miles W of Charleston  
(distance) (direction) (nearest town)

WELL PURPOSE:  
(home, irrigation, municipal, industrial)

WELL COMPLETION DATA:


- (1) diameter (inches) 4"
- (2) total depth (feet) 190
- (3) static water level (feet) 120 below top of ground.
- (4) casing Plastic, 185 (material) (depth)  
If telescope see back.  
(size)
- (5) screen 5, 185 (length) (depth to top)  
2, Plastic (size) (material)
- (6) pump 1/2, 10 (HP) (yield gpm)  
Elret (type power)
- (7) electric log No (yes or no)

CODED

(organization running log)

(8) how well bottom plugged Wash  
Bottom

DRILLERS REMARKS:

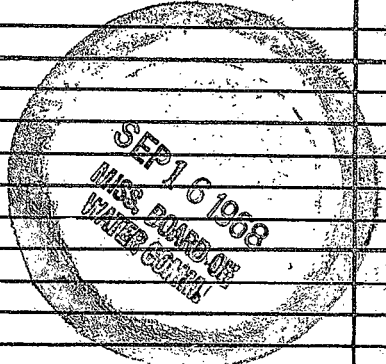

If well telescopes please sketch and show depths.

GROUND LEVEL

			<del>34</del> x

SECTION 34

Please indicate well location X.

ADDITIONAL INFORMATION

If more than one screen, show locations of each on sketch.