

Tallahatchie
 A 24
 5-14-75

MISSISSIPPI
 BOARD OF WATER COMMISSIONERS
 416 North State Street
 Jackson, Mississippi 39201

CODED

WATER WELL DRILLERS LOG

5-14 1975 date well completed
 B-Lipe well Co firm name
 Tallahatchie county well located

LANDOWNER:	description of formations encountered	from	to
Bennie Grissom Charleston Miss. (mailing address)			
WELL LOCATION: sec <u>13</u> T <u>26</u> N R <u>2</u> E 15F S W <u>7</u> miles west of <u>Enid</u> (distance) (direction) (nearest town)			
WELL PURPOSE: (home) irrigation, municipal, industrial			
WELL COMPLETION DATA:			
(1) diameter (inches) <u>4</u>			
(2) total depth (feet) <u>100</u>			
(3) static water level (feet) <u>80</u> below above top of ground.			
(4) casing <u>PVC</u> <u>90</u> (material) (depth)			
<u>4</u> if telescope see back. (size)			
(5) screen <u>10</u> <u>90</u> (length) (depth to top)			
<u>1</u> <u>PVC</u> (size) (material)			
(6) pump <u>3/4</u> <u>10</u> (HP) (yield gpm)			
<u>elec</u> (type power)			
(7) electric log <u>no</u> (yes or no)			
<u>no</u> (organization running log)			
(8) how well bottom plugged <u>PVC</u> <u>0.75</u>			
DRILLERS REMARKS:			

CODED


well OK

REGISTERED
 MISSISSIPPI
 14 1975

MISS. Bd. OF WATER COMMISSIONERS

If well telescopes please sketch and show depths.

GROUND LEVEL

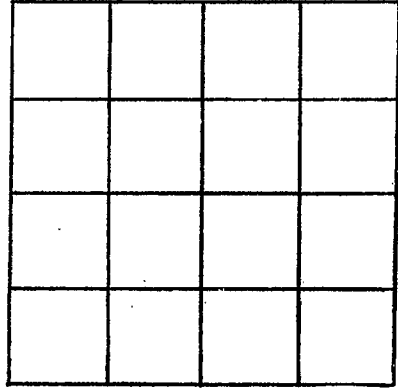

SECTION _____

Please indicate well location X.

ADDITIONAL INFORMATION

If more than one screen,
show locations of each on sketch.