

MISSISSIPPI DEPARTMENT OF NATURAL RESOURCES

Bureau of Land and Water Resources

Southport Mall

CODED

P.O. Box 10631

Jackson, Mississippi 39209

WATER WELL DRILLERS LOG

A 25  
 LAWAHATCHIE  
 4-84 GW06562

April 84 date well completed  
 Leeper Drilling firm name  
 Tallahatchie county well located

LANDOWNER: Sam Hanson

description of formations encountered	from	to
TOP clay	0	10
Blue clay	10	40
fine sand	40	50
Coarse sand and gravel	50	96

Charleston MS  
 (mailing address)

WELL LOCATION:  
 sec. 28 T. 26 N. R. 2 E.  
7 21 S. W.  
7 21 miles (distance) N (direction) of Charleston (nearest town)

WELL PURPOSE: irrigation  
 (home, irrigation, municipal, industrial)

WELL COMPLETION DATA:

- (1) diameter (inches) 12"
- (2) total depth (feet) 96'
- (3) static water level (feet) 31 below top of ground.
- (4) casing PVC, 56' (material) (depth)
- 12" (size) if telescope see back.
- (5) screen 40', 56' (length) (depth to top)
- 12" (size), PVC (material)
- (6) pump 80, 1400 (HP) (yield gpm)
- Diesel (type power)
- (7) electric log NO (yes or no)

(organization running log)

(8) how well bottom plugged well cap

DRILLERS REMARKS:


DEPT. OF NATURAL RESOURCES  
 BUREAU OF LAND & WATER RESOURCES

MAY 31 1984

RECEIVED

If well telescopes please sketch and show depths.

GROUND LEVEL

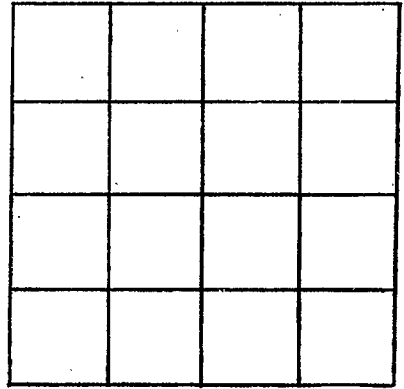

SECTION \_\_\_\_\_

Please indicate well location X.

ADDITIONAL INFORMATION

If more than one screen, show locations of each on sketch.