

MISSISSIPPI DEPARTMENT OF NATURAL RESOURCES

Bureau of Land and Water Resources

Southport Mall

P.O. Box 10631

Jackson, Mississippi 39209

WATER WELL DRILLERS LOG

CODED

TALLAHATCHIE
A 26

5/29/84
date well completed

1984 Dyer well
firm name

Tallahatchie
county well located

LANDOWNER: School Board
16th Section Land
Charleston, Miss.
(mailing address)

description of formations encountered	from	to
Clay	0	38
Fine sand	38	76
Sand + Gravel	76	113

WELL LOCATION:
sec. 16 T 26 N R 2 E
S W
8 miles North of Charleston
(distance) (direction) (nearest town)

WELL PURPOSE: Irrigation
(home, irrigation, municipal, industrial)

- WELL COMPLETION DATA:
- (1) diameter (inches) 12"
 - (2) total depth (feet) 113'
 - (3) static water level (feet) 29' below above top of ground.
 - (4) casing STEEL (material), 73' (depth),
12 (size) if telescope see back.
 - (5) screen 40 ft (length), 63' (depth to top),
12" (size), slud (material)
 - (6) pump 40 (HP), 2000 (yield gpm),
Disc Electric (type power)
 - (7) electric log No (yes or no),
No (organization running log)
 - (8) how well bottom plugged STEEL PLATE

DRILLERS REMARKS:

CODED


DEPT. OF NATURAL RESOURCES
BUREAU OF LAND & WATER RESOURCES

JUL - 2 1984

RECEIVED

If well telescopes please sketch and show depths.

GROUND LEVEL

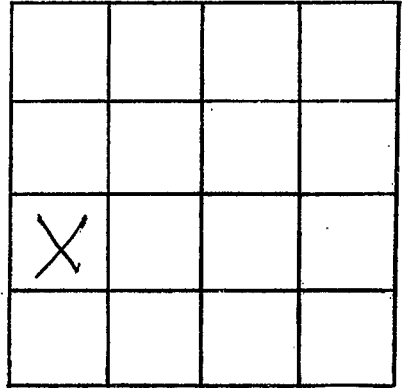

SECTION 16

Please indicate well location X.

ADDITIONAL INFORMATION

If more than one screen, show locations of each on sketch.