

K 28
Tallahatchie
6-30-84

MISSISSIPPI
BOARD OF WATER COMMISSIONERS
416 North State Street
Jackson, Mississippi 39201

CODED

WATER WELL DRILLERS LOG

Series 20 1984 Lipel Well Supply Tallahatchie
date well completed firm name county well located

LANDOWNER: <u>Tommy Florence</u>	description of formations encountered	from	to
<u>Proprietor</u>			
(mailing address)	<u>Sand</u>	<u>20</u>	<u>20</u>

WELL LOCATION:
sec. 16 T 260 S R 2 E
8 miles W of End
(distance) (direction) (nearest town)

CODED

WELL PURPOSE: Municipal
(home, irrigation, municipal, industrial)

- WELL COMPLETION DATA:
- (1) diameter (inches) 10
 - (2) total depth (feet) 90
 - (3) static water level (feet) 15 below above top of ground.
 - (4) casing Steel, 50,
(material) (depth)
10 if telescope see back.
(size)
 - (5) screen 40, 50
(length) (depth to top)
10, Steel
(size) (material)
 - (6) pump 110 1000
(HP) (yield gpm)
diesel
(type power)
 - (7) electric log No
(yes or no)

(organization running log)

(8) how well bottom plugged Steel
plate

DRILLERS REMARKS:


DEPT. OF NATURAL RESOURCES
BUREAU OF LAND & WATER RESOURCES

JUL 10 1984

RECEIVED

If well telescopes please sketch and show depths.

GROUND LEVEL

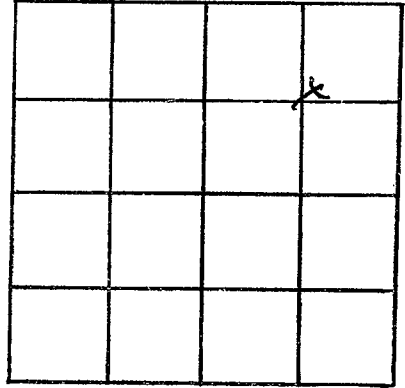

SECTION 16

Please indicate well location X.

ADDITIONAL INFORMATION

If more than one screen,
show locations of each on sketch.