

MISSISSIPPI DEPARTMENT OF NATURAL RESOURCES

Bureau of Land and Water Resources

Southport Mall

P.O. Box 10631

Jackson, Mississippi 39209

WATER WELL DRILLERS LOG

CODED

Tallahatchie  
A29  
8/01/84

GW 3440 *SM*

Aug 1 1984  
 date well completed

Leeper Drilling  
 firm name

Tallahatchie  
 county well located

LANDOWNER:

Bill Newton

Hiway 35 North

Charleston Ms

(mailing address)

WELL LOCATION:

sec. 8 T 26 (N) R. 2 (E)  
 S W

8 miles N of Charleston  
 (distance) (direction) (nearest town)

WELL PURPOSE:

Residential  
 (home, irrigation, municipal, industrial)

WELL COMPLETION DATA:

- (1) diameter (inches) 10"
- (2) total depth (feet) 100 ft
- (3) static water level (feet) 9 below top of ground. above
- (4) casing PVC 60  
 (material) (depth)  
10" if telescope see back.  
 (size)
- (5) screen 40' 60'  
 (length) (depth to top)  
10" PVC  
 (size) (material)
- (6) pump 40 1500  
 (HP) (yield gpm)  
Diesel  
 (type power)
- (7) electric log (yes or no) \_\_\_\_\_  
 (organization running log) \_\_\_\_\_
- (8) how well bottom plugged CAF

description of formations encountered

from

to

TOP clay 0 10  
Fine Sand 10 40  
Coarse Sand  
and Gravel 40 100

CODED

DEPT. OF NATURAL RESOURCES  
 BUREAU OF LAND & WATER RESOURCES


AUG 3 1984

RECEIVED

DRILLERS REMARKS:

If well telescopes please sketch and show depths.

GROUND LEVEL

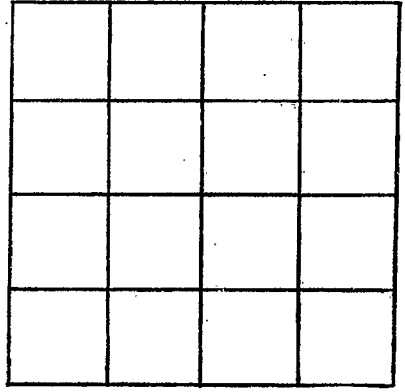

SECTION \_\_\_\_\_

Please indicate well location X.

ADDITIONAL INFORMATION

A series of horizontal lines for recording additional information.

If more than one screen, show locations of each on sketch.